


Section 18 Township 11 Range 16-W

Well Number #4 Romine

Company Lario

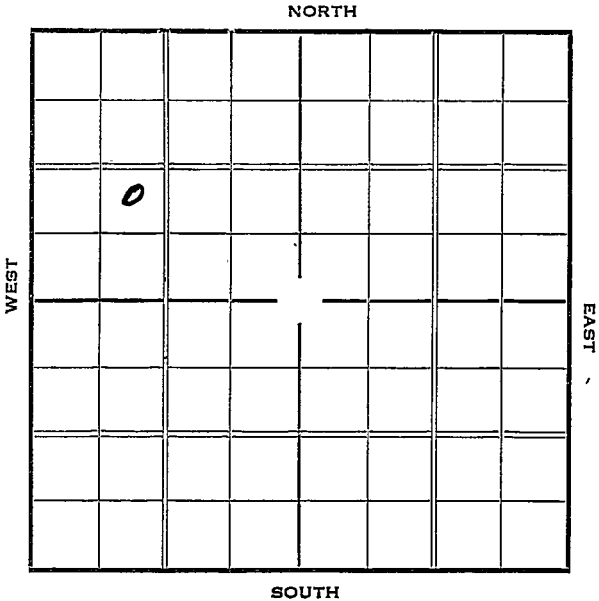

1937

12/1

5" @ 3425'.

Sil. 3322-3770'.

Regan 3770-75'.

Arkosic sand 3775-83'.

T.D. 3783'.

Salt water disposal.

No test.

ABANDONED

Map No. _____ Sec. 18 Twp. 11 R16WWell No. 4 RomineLario

Company

Contractor

FIRST REPORT

NE SW NW

_____ Ft. from N. Line

990 Ft. from S. Line

_____ Ft. from E. Line

990 Ft. from W. Line

SECTION PLAT

0			

Location X

Rig up _____

Drilling and Remarks:

RECORD

Cased _____ in., _____ ft.

Sand _____

Gas _____

Oil _____

Total Depth _____

PRODUCTION

1st 24 hrs. Nat. _____

1st 24 hrs. after shot _____

Gas _____ Cu. Ft.

Dry Hole _____

Abandoned _____

Date

OCT 13 1937 19H. D. Hatfield Scout

Ellis KANSAS

Map No. 71 Sec. 18 Twp. 11 R. 16WWell No. 4 RomineLario

Company

Contractor

COMPLETED

NE SW NW

 Ft. from N. Line990 Ft. from S. Line Ft. from E. Line990 Ft. from W. Line

SECTION PLAT

0			

Location Rig up

Drilling and Remarks:

*Sil 3322-3770**Regan 3770-75**Arkosit sand 3775-83**Salt water disposal**No Test*

RECORD

Cased 5 in., 3425 ft.Sand Gas Oil Total Depth 3783

PRODUCTION

1st-24 hrs. Nat. 1st 24 hrs. after shot Gas Cu. Ft.Dry Hole Abandoned

Date

DEC 1- 1937

19

H. D. Hatfield

Scout