

KANSAS

Ellis


Form 51-5M-7-39-Palace

Section 18 Township 11 Range 17-W

Well No. #1 Carmichael "B"

Company Dickey Oil

NORTH Bemis Pool

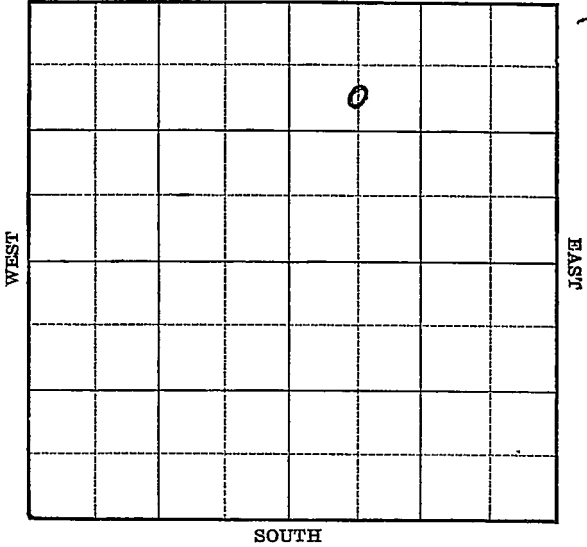

Sec. 18 Twp. 11 R. 17-W

Well No. #1 Carmichael "B" Farm

Dickey Oil Company

(Bemis)


990 Ft. from N. Line

_____ Ft. from S. Line

_____ Ft. from E. Line

660 Ft. from W. Line

Elev. 1857

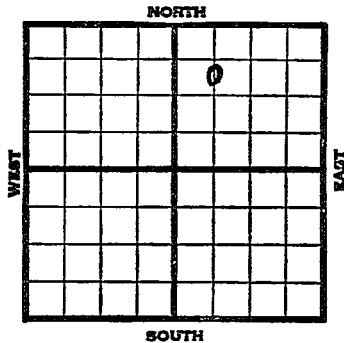

1940	REPORT
1/10	Derrick.
1/18	Rotary.
1/25	Anhy 1089' 10" - 1118' WOC.
2/1	Drlg. 2250'
2/8	Drlg. 3080'
2/15	Arb. 336 1/2' 7" - 336 1/2'
	T.D. 3367' 3100' oil 2 hours.
2/21	Arb. 336 1/2'
	7" - 336 1/2'
	T.D. 3367'
	5000 acid.
	Depthograph potential 4173 bbls.
	Maximum 3000 bbls.
	COMPLETED

Ellis KANSAS

Map No. 71 Sec. 18 Twp. 11 R. 17WWell No. 1 Carmichael "B"Dickey Oil

Company

Contractor

FIRST REPORT

C S $\frac{1}{2}$ NW NE

SECTION PLAT

990 Ft. from N. Line

_____ Ft. from S. Line

_____ Ft. from E. Line

660 Ft. from W. Line

		o	

BEMIS POOL

Location _____

Rig up _____

Drilling and Remarks:

Derrick

RECORD

Cased _____ in., _____ ft.

Sand _____

Gas _____

Oil _____

Total Depth _____

PRODUCTION

1st 24 hrs. Nat. _____

1st 24 hrs. after shot _____

Gas _____ Cu. Ft.

Dry Hole _____

Abandoned _____

Date

JAN 10 1940 19S. J. LEWIS Scout

Map No. 71 Sec. 18 Twp. 11 R. 17WWell No. 1 Carmichael "B"Dickey

Company

Contractor

COMPLETED

C $S\frac{1}{2}$ NW NE990 Ft. from N. Line

_____ Ft. from S. Line

_____ Ft. from E. Line

660 Ft. from W. Line

SECTION PLAT

		o	

BEMIS POOL

Location _____

Rig up _____

Drilling and Remarks:

*Core 336 1/2**7" @ 336 1/2**5000 acid**Depthograph 4173**Max 3000*

RECORD

Cased _____ in., _____ ft.

Sand _____

Gas _____

Oil _____

Total Depth 3367

PRODUCTION

1st 24 hrs. Nat. _____

1st 24 hrs. after shot _____

Gas _____ Cu. Ft.

Dry Hole _____

Abandoned _____

Date

FEB 21 1940 19

S. J. LEWIS Scout