


Section 18 Township 11 Range 17-W

Well No. 1 Carmichael

Company Dickey

NORTH Burnett South Pool

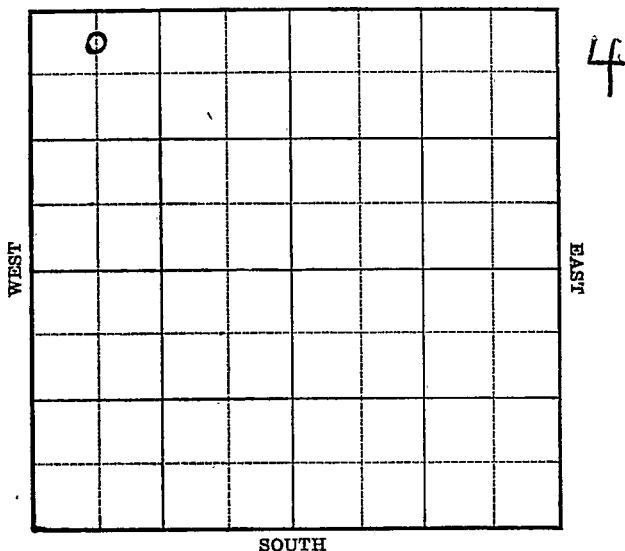

Sec. 18 Twp. 11 R. 17-W

Well No. #1 Carmichael Farm

Dickey Company

(Burnett South)


330 Ft. from N. Line

_____ Ft. from S. Line

_____ Ft. from E. Line

660 Ft. from W. Line

Elev. 1847

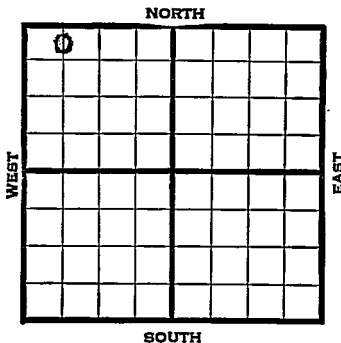

| 1939 | REPORT |
|------|---------------------------------------|
| 5/24 | Location |
| 6/1 | " |
| 6/8 | " |
| 6/16 | " |
| 6/23 | Rotary. |
| 6/29 | 15" - 150' Drlg. 800' |
| 7/6 | Anhy 1079' 10" - 1096' Drlg. 1900' |
| 7/13 | Lans. 3047' Drlg. 3113' |
| 7/20 | Arb. 3331' 7" - 3331' |
| | T.D. 3340' 1500' oil 1 hour. |
| | 2000 acid. 2600' oil 2 hrs. |
| 7/26 | Arb. 3331' |
| | T.D. 3341' |
| | 7" - 3331' |
| | 2000 acid. |
| | Depthograph potential 22,900 bbl |
| | Maximum 3500 bbls. |
| | COMPLETED |

Ellis

Map No. 71 Sec. 18 Twp. 11 R. 17W

Well No. 1 Carmichael

Dickey

Company

Contractor

FIRST REPORT

C $N\frac{1}{2}$ NW NW

SECTION PLAT

330 Ft. from N. Line

_____ Ft. from S. Line

_____ Ft. from E. Line

660 Ft. from W. Line

| | | | |
|---|--|--|--|
| 0 | | | |
| | | | |
| | | | |
| | | | |
| | | | |

BURNETT SOUTH POOL

Location X

Rig up _____

Drilling and Remarks:

RECORD

Cased _____ in., _____ ft.

Sand _____

Gas _____

Oil _____

Total Depth _____

PRODUCTION

1st 24 hrs. Nat. _____

1st 24 hrs. after shot _____

Gas _____ Cu. Ft.

Dry Hole _____

Abandoned _____

Date

MAY 24 1939

19

S. J. LEWIS

Scout

Map No. 71 Sec. 18 Twp. 11 R. 17W

Well No. 1 Carmichael

Dickey Oil

Company

Contractor

COMPLETED

SECTION PLAT

330 C N $\frac{1}{2}$ NW NW
Ft. from N. Line

_____ Ft. from S. Line

_____ Ft. from E. Line

660 Ft. from W. Line

| | | | |
|---|--|--|--|
| 0 | | | |
| | | | |
| | | | |
| | | | |

BURNETT SOUTH POOL

Location _____

Rig up _____

Drilling and Remarks: _____

Core 8 3331

7" @ 3331

2000 cad

Depthograph

22,900

Maximum 3500

RECORD

Cased _____ in., _____ ft.

Sand _____

Gas _____

Oil _____

Total Depth 3341

PRODUCTION

1st 24 hrs. Nat. _____

1st 24 hrs. after shot _____

Gas _____ Cu. Ft.

Dry Hole _____

Abandoned _____

Date

JUL 26 1939 19

WMS

Scout