


Section 18 Township 11 Range 17-W

Well No. #2 Carmichael

Company Dickey Oil

NORTH Burnett South Pool

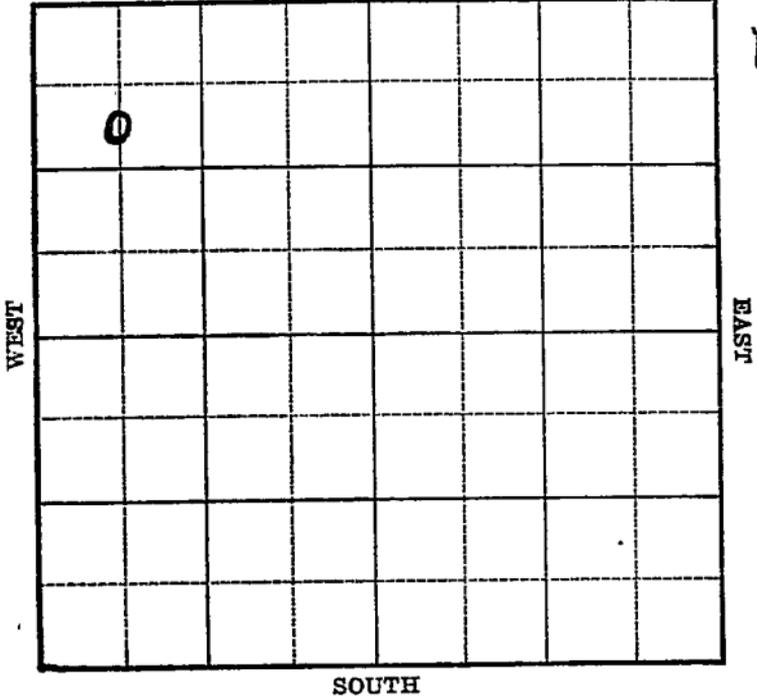

KANSAS

Ellis

Sec. 18 Twp. 11 R. 17-W

Well No. #2 Carmichael Farm

Dickey Oil Company

(South Burnett)


990 Ft. from N. Line

_____ Ft. from S. Line

_____ Ft. from E. Line

660 Ft. from W. Line

Elev. 1842

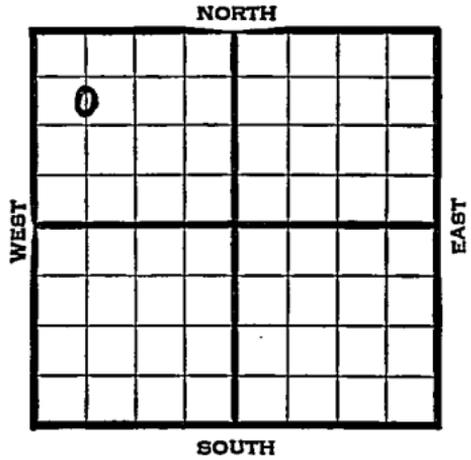

1939	REPORT
7/12	Location
7/20	15" - 60' Drlg. 865'
7/27	Anhy 1070' 10" - 1103'
	Drlg. 1900'
8/3	Drlg. 3100'
8/10	Arb. 3326' 7" - 3326'
	T.D. 3327' RUST.
8/16	Arb. 3326'
	7" - 3326'
	T.D. 3332'
	Depthograph potential 34,996 bbls
	Maximum 3500 bbls.
	<u>COMPLETED</u>

Map No. _____ Sec. 18 Twp. 11 R. 17WWell No. 2 CarmichaelDickey Oil

Company _____

Contractor _____

FIRST REPORT

C S $\frac{1}{2}$ NW NW

SECTION PLAT

990 Ft. from N. Line

_____ Ft. from S. Line

_____ Ft. from E. Line

660 Ft. from W. Line

o			

BURNETT SOUTH POOL

Location X

Rig up _____

Drilling and Remarks: _____

RECORD

Cased _____ in., _____ ft.

Sand _____

Gas _____

Oil _____

Total Depth _____

PRODUCTION

1st 24 hrs. Nat. _____

1st 24 hrs. after shot _____

Gas _____ Cu. Ft.

Dry Hole _____

Abandoned _____

Date

JUL 12 193919S. J. LEWIS Scout

Map No. 71 Sec. 18 Twp. 11 R. 17WWell No. 2 CarmichaelDickey Oil Company

Contractor

COMPLETE**SECTION PLAT**C S $\frac{1}{2}$ NW NW990 Ft. from N. Line

_____ Ft. from S. Line

_____ Ft. from E. Line

660 Ft. from W. Line**BURNETT SOUTH POOL**

o		.	.

Location _____

Rig up _____

Drilling and Remarks:

*Core 8 3326**7" @ 3326.**Depthograph 34996**Maximum 3500***RECORD**

Cased _____ in., _____ ft.

Sand _____

Gas _____

Oil _____

Total Depth 3332**PRODUCTION**

1st 24 hrs. Nat. _____

1st 24 hrs. after shot _____

Gas _____ Cu. Ft.

Dry Hole _____

Abandoned _____

Date

Nov - 1939S. J. LEWIS Scout