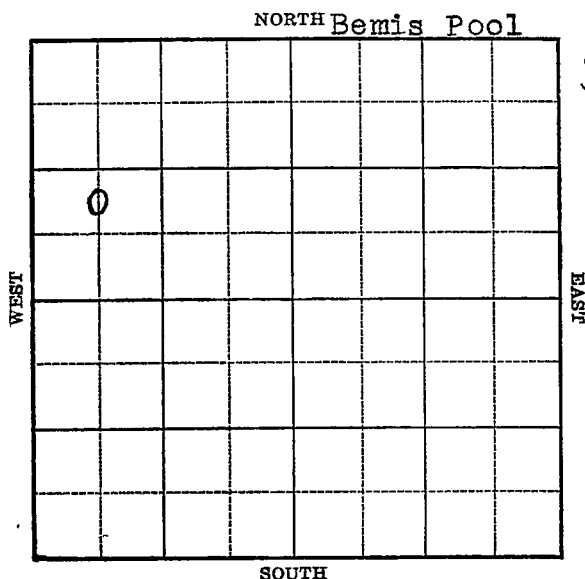


Ellis

KANSAS

Section 18 Township 11 Range 17-WWell No. #3 CarmichaelCompany Dickey

KANSAS

Ellis

Sec. 18 Twp. 11 R. 17-W

Well No. #3 Carmichael Farm

Dickey _____ Company

(Bemis)


Ft. from N. Line

99.0 Ft. from S. Line

Ft. from E. Line

66.0 Ft. from W. Line

Elev. 1852

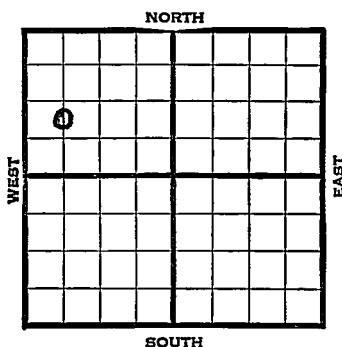[illegible]

Ellis

KANSAS

Map No. _____ Sec. 18 Twp. 11 R. 17WWell No. 3 CarmichaelDickey

Company _____

Contractor _____

FIRST REPORT

C N $\frac{1}{2}$ SW NW

_____ Ft. from N. Line

990 Ft. from S. Line

_____ Ft. from E. Line

660 Ft. from W. Line

SECTION PLAT

o			

BEMIS POOL

Location X

Rig up _____

Drilling and Remarks: _____

RECORD

Cased _____ in., _____ ft.

Sand _____

Gas _____

Oil _____

Total Depth _____

PRODUCTION

1st 24 hrs. Nat. _____

1st 24 hrs. after shot. _____

Gas _____ Cu. Ft.

Dry Hole _____

Abandoned _____

Date

AUG 2 1939

19

S. J. LEWIS Scout

Ellis

KANSAS

Map No. 71 Sec. 18 Twp. 11 R. 17WWell No. 3 Carmichael

Dickey Oil

Company

Contractor

COMPLETED

C $N\frac{1}{2}$ SW NW

Ft. from N. Line

990 Ft. from S. Line

Ft. from E. Line

660 Ft. from W. Line

SECTION PLAT

0			

BEMIS POOL

Location _____

Rig up _____

Drilling and Remarks:

*Art. 3337 1/2**5" C 3337**Depthograph Log*
*3400**Maximum 2500*

RECORD

Cased _____ in., _____ ft.

Sand _____

Gas _____

Oil _____

Total Depth 3339

PRODUCTION

1st 24 hrs. Nat. _____

1st 24 hrs. after shot _____

Gas _____ Cu. Ft.

Dry Hole _____

Abandoned _____

Date

SEP 6 1939

19

S. J. LEWIS Scout