


Section 18 Township 11 Range 17-W

Well No. #7 Carmichael "A"

Company Dickey Oil

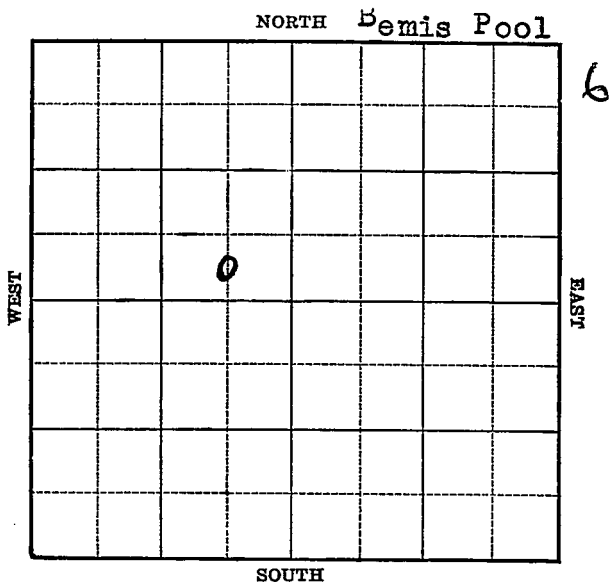

Sec. 18 Twp. 11 R. 17-W

Well No. #7 Carmichael "A" Farm

Dickey Oil Company


(Bemis)

\_\_\_\_\_ Ft. from N. Line

330 Ft. from S. Line

660 Ft. from E. Line

\_\_\_\_\_ Ft. from W. Line

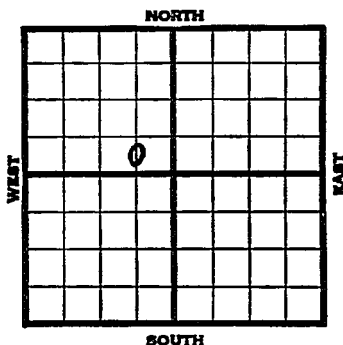

Elev. 1885

1940	REPORT
2/21	Location
2/29	Derrick.
3/8	"
3/14	"
3/21	"
3/28	15" - 38' Anhy 1125'
	10" - 1145' WOC.
4/4	Drlg. 2710'
4/12	Drlg. 3375'
4/18	Arb. 3392' 7" - 3392'
	T.D. 3399' H.F.O. 500 acid.WOA.
4/24	Arb. 3392'
	7" - 3392'
	T.D. 3399'
	500 acid.
	Depthograph 16,000 bbls.
	Maximum 3000 bbls.
	<b>COMPLETED</b>

Map No. 71 Sec. 18 Twp. 11 R. 17WWell No. 7 Carmichael "A"Dickey Oil Company

Contractor

## FIRST REPORT

C S L SE NW

     Ft. from N. Line330 Ft. from S. Line660 Ft. from E. Line     Ft. from W. Line

## SECTION PLAT


## BEMIS POOL

Location XRig up     

Drilling and Remarks:

## RECORD

Cased      in.,      ft.Sand     Gas     Oil     Total Depth     

## PRODUCTION

1st 24 hrs. Nat.     1st 24 hrs. after shot     Gas      Cu. Ft.Dry Hole     Abandoned     

Date

FEB 21 1940 19 S. J. LEWIS Scout

Map No. 71 Sec. 18 Twp. 11 R. 17WWell No. 7 Carmichael "A"Dickey Oil Company

Contractor

COMPLETED

C S L SE SW

SECTION PLAT

       Ft. from N. Line330 Ft. from S. Line660 Ft. from E. Line       Ft. from W. Line

Bemis Pool


Location       Rig up       

Drilling and Remarks:

*As 3392.**7" @ 3392.**500 @ oil**Depthograph 16000**Maximum 3000*

## RECORD

Cased        in.,        ft.Sand       Gas       Oil       Total Depth 3399

## PRODUCTION

1st 24 hrs. Nat.       1st 24 hrs. after shot       Gas        Cu. Ft.Dry Hole       Abandoned       

Date

APR 24 1940 19S. J. LEWIS Scout