

KANSAS

Form 51-5M-7-39-Palace


Ellis

Section 18 Township 11 Range 17-W

Well No. #1 R. Kollman

Company Dickey

NORTH Bemis Pool

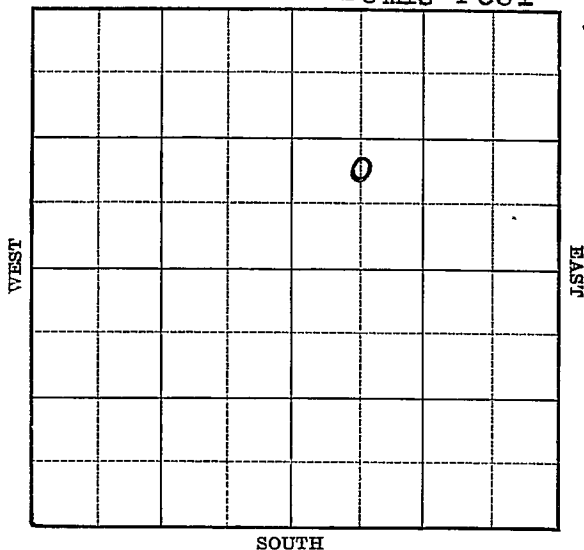

Sec. 18 Twp. 11 R. 17-W

Well No. #1 R. Kollman Farm

Dickey Company

(Bemis)


 Ft. from N. Line

990 Ft. from S. Line

 Ft. from E. Line

660 Ft. from W. Line

Elev. 1860

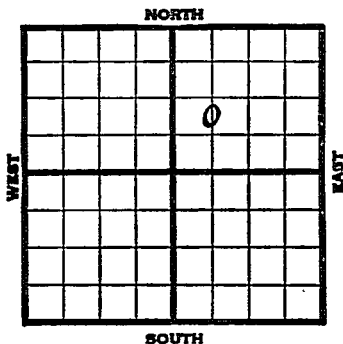

1939	REPORT
10/11	Location
10/19	Cellar.
10/26	Rotary.
11/2	Drlg. 300'
11/9	15" - 45' 10" - 1110'
	Drlg. 2055'
11/16	Topeka 2936' Drlg. 3040'
11/23	Lans. 3120' Arb. 3360'
	7" - 3360' T.D. 3363'
	2000' oil.
11/28	Arb. 3360'
	7" - 3360'
	T.D. 3363'
	Depthograph potential 6078 bbls.
	Maximum 3500 bbls.
	COMPLETED

Map No. 77 Sec. 18 Twp. 11 R. 17WWell No. 1 R. KollmanDickey

Company

Contractor

FIRST REPORT

C $N\frac{1}{2}$ SW NE Ft. from N. Line990 Ft. from S. Line Ft. from E. Line660 Ft. from W. Line

SECTION PLAT

		o	

BEMIS POOL

Location XRig up

Drilling and Remarks:

RECORD

Cased in., ft.Sand Gas Oil Total Depth

PRODUCTION

1st 24 hrs. Nat. 1st 24 hrs. after shot Gas Cu. Ft.Dry Hole Abandoned

Date

OCT 11 1939

19

S. J. LEWIS

Scout

Map No. 71 Sec. 18 Twp. 11 R. 17WWell No. 1 R. KollmanDickey

Company

Contractor

COMPLETEDC $N\frac{1}{2}$ SW NE

_____ Ft. from N. Line

990 Ft. from S. Line

_____ Ft. from E. Line

660 Ft. from W. Line

BEMIS POOL

SECTION PLAT

		o	

Location _____

Rig up _____

Drilling and Remarks:

*Cr 83360**7" @ 3360**Depthograph P 8
608**Maximum 3500***RECORD**

Cased _____ in., _____ ft.

Sand _____

Gas _____

Oil _____

Total Depth 3363**PRODUCTION**

1st 24 hrs. Nat. _____

1st 24 hrs. after shot _____

Gas _____ Cu. Ft.

Dry Hole _____

Abandoned _____

Date

NOV 28 1939 19

S. J. LEWIS

Scout