

KANSAS

Form 51-5M-7-39-Palace


Ellis

Section 18 Township 11 Range 17-W

Well No. #2 Kollman

Company Dickey Oil

NORTH Bemis Pool

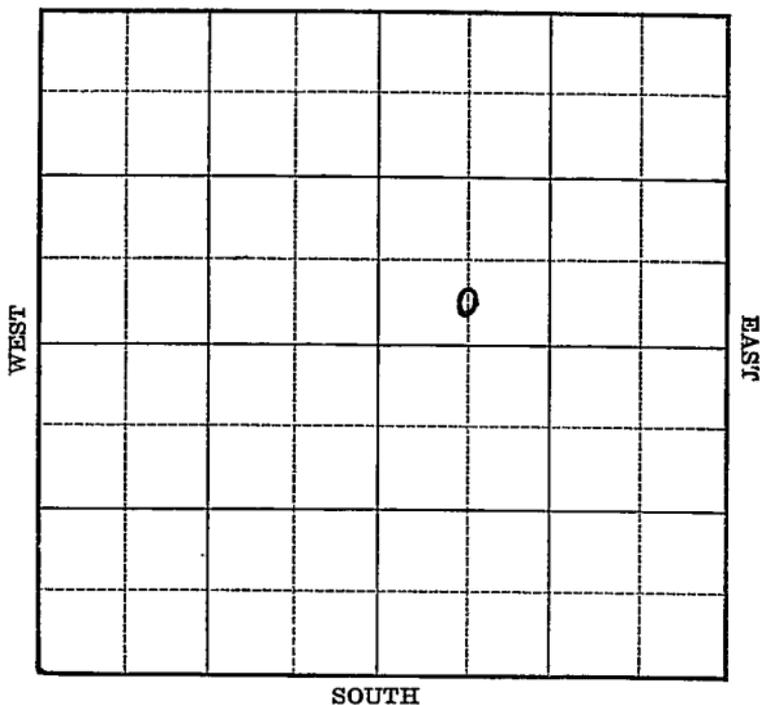

Sec. 18 Twp. 11 R. 17-W

Well No. #2 Kollman Farm

Dickey Oil Company

(Bemis)


_____ Ft. from N. Line

330 Ft. from S. Line

_____ Ft. from E. Line

660 Ft. from W. Line

Elev. 1859

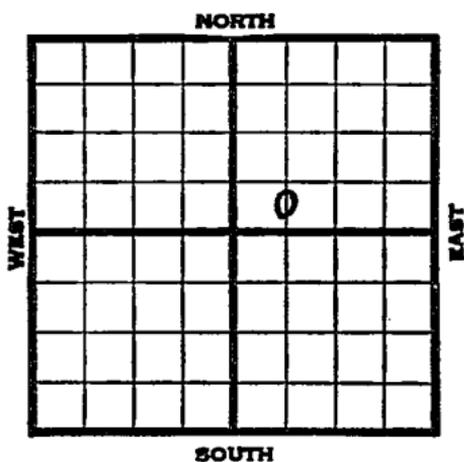

	REPORT
1940	
1/31	Cellar.
2/8	Derrick.
2/15	"
2/23	Drlg. 1140'
2/29	Anhy 1110' 10" - 1117'
	Drlg. 2287'
3/8	Drlg. 3253'
3/14	Arb. 3360' 7" - 3360' TRX
	T.D. 3370' 2600' oil 4 hours.
3/20	Arb. 3360'
	7" - 3360'
	T.D. 3370'
	500 acid.
	Depthograph potential 17,370 bbl
	Maximum 3000 bbls.
	COMPLETED

Map No. 71 Sec. 18 Twp. 11 R. 17WWell No. 2 KollmanDickey Oil

Company

Contractor

COMPLETED
C S L SW NE**SECTION PLAT**

		o	

_____ Ft. from N. Line

330 Ft. from S. Line

_____ Ft. from E. Line

660 Ft. from W. Line**BURNETT ARB. POOL**

Location _____

Rig up _____

Drilling and Remarks:

*Cor. 3360**7" @ 3360**500 acid**Depthograph 17370**Maximum 3000***RECORD**

Cased _____ in., _____ ft.

Sand _____

Gas _____

Oil _____

Total Depth 3370**PRODUCTION**

1st 24 hrs. Nat. _____

1st 24 hrs. after shot _____

Gas _____ Cu. Ft.

Dry Hole _____

Abandoned _____

Date

MAR 20 1940₁₉S. J. LEWIS Scout