

KANSAS


Ellis

Form 51-5M-7-40-Palace

Section 18 Township 11 Range 17-W

Well No. #6 Kollman

Company Dickey

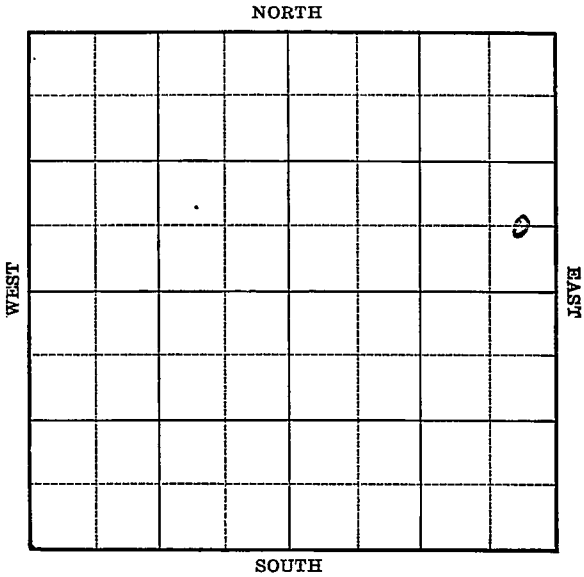

Sec. 18 Twp. 11 R. 17-W

Well No. #6 Kollman Farm

Dickey Company

(Bemis)


_____ Ft. from N. Line

66.0 Ft. from S. Line

330 Ft. from E. Line

_____ Ft. from W. Line

Elev. 1837

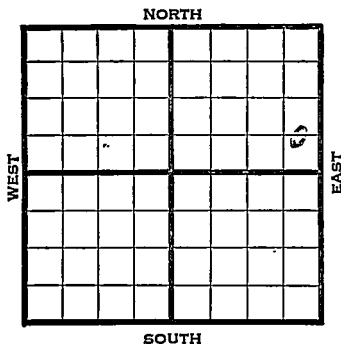

1941	REPORT
2/12	Location
2/20	Derrick.
2/27	"
3/6	15" - 35' Anhy 1085'
	10" - 1108' Drlg. 1660'
3/13	Drlg. 2980'
3/20	Arb. 3331½-33' T.D.
	7" - 3331½' RUST.
3/26	Arb. 3331½'
	7" - 3331½'
	T.D. 3341'
	1000 acid.
	Echometer potential 31,656 bbls.
	Maximum 3000 bbls.
	33.5 Gravity
	COMPLETED

Map No. 71 Sec. 18 Twp. 11 R. 17WWell No. 6 KollmanDickey

Company

Contractor

FIRST REPORT**SECTION PLAT**

C E L S E N E

 Ft. from N. Line660 Ft. from S. Line330 Ft. from E. Line Ft. from W. Line

			o

BEMIS POOL

Location XRig up Drilling and Remarks: **RECORD**Cased in., ft.Sand Gas Oil Total Depth **PRODUCTION**1st 24 hrs. Nat. 1st 24 hrs. after shot Gas Cu. Ft.Dry Hole Abandoned

Date

FEB 12 1941 19S. J. LEWIS

Scout

Map No. 71 Sec. 18 Twp. 11 R. 17W

Well No. 6 Kollman

Dickey Oil Company

Contractor

~~COMPLETED~~

SECTION PLAT

C E L S E N E

 Ft. from N. Line

660 Ft. from S. Line

330 Ft. from E. Line

 Ft. from W. Line

			e

BEMIS POOL

Location

Rig up

Drilling and Remarks:

cut 333 1/2

7" @ 333 1/2

1000 acid

Eclor Pot. 316 5/6

Mat 3000

33.5 Yrs.

RECORD

Cased in., ft.

Sand

Gas

Oil

Total Depth 3341

PRODUCTION

1st 24 hrs. Nat.

1st 24 hrs. after shot

Gas Cu. Ft.

Dry Hole

Abandoned

Date

MAR 26 1941₁₉

S. J. LEWIS

Scout