

KANSAS

Form 51-5M-7-40-Palace


Ellis

Section 18 Township 11 Range 17-W

Well No. 8 Kollman

Company Dickey Oil

NORTH Bemis Pool

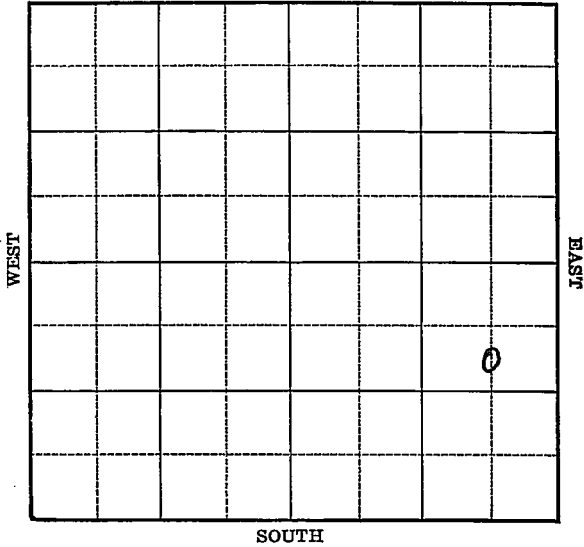

Sec. 18 Twp. 11 R. 17-W

Well No. #8 Kollman Farm

Dickey Oil Company

(Bemis)


990 Ft. from N. Line

_____ Ft. from S. Line

660 Ft. from E. Line

_____ Ft. from W. Line

Elev. 1838

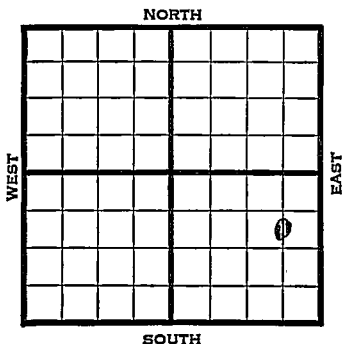

1941	REPORT
5/14	Derrick.
5/22	Rotary.
5/28	15" - 33' Anhy 1088'
	10" - 1110' WOC.
6/5	Drlg. 2800'
6/12	Cong. 3328 3328' T.D. 3363'
	Shut down.
6/18	Cong. 3328'
	T.D. 3488' in Cong.
	ABANDONED

Map No. 41 Sec. 18 Twp. 11 R. 17WWell No. 8 KollmanDickey Oil

Company

Contractor

FIRST REPORT**SECTION PLAT**

C S L N E S E

990 Ft. from N. Line

_____ Ft. from S. Line

660 Ft. from E. Line

_____ Ft. from W. Line

BEMIS POOL

			o

Location _____

Rig up _____

Drilling and Remarks:

Derrick**RECORD**

Cased _____ in., _____ ft.

Sand _____

Gas _____

Oil _____

Total Depth _____

PRODUCTION

1st 24 hrs. Nat: _____

1st 24 hrs. after shot _____

Gas J _____ Cu. Ft.

Dry Hole _____

Abandoned _____

Date

MAY 14 1941 19S. J. LEWIS Scout

Map No. _____ Sec. 18 Twp. 11 R. 17WWell No. 8 KollmanDickey Oil

Company

Contractor

ABANDONED**SECTION PLAT**

C S L N E S E

990 Ft. from N. Line

_____ Ft. from S. Line

660 Ft. from E. Line

_____ Ft. from W. Line

			o

BEMIS POOL

Location _____

Rig up _____

Drilling and Remarks:

Cong 3328.
2488 in Cong.

RECORD

Cased _____ in., _____ ft.

Sand _____

Gas _____

Oil _____

Total Depth 2488**PRODUCTION**

1st 24 hrs.-Nat. _____

1st 24 hrs. after shot _____

Gas _____ Cu. Ft.

Dry Hole _____

Abandoned _____

Date

JUN 1 8 1941 19S. J. LEWIS

Scout