


Section 18 Township 11 Range 17W

Well No. #4 Husted

Company Dickey Oil

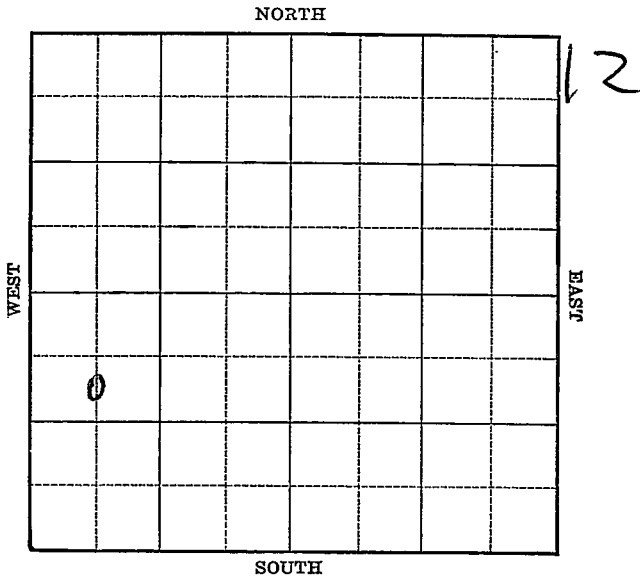

Sec. 18 Twp. 11 R. 17-W

Well No. #4 Husted Farm

Dickey Oil Company

(Burnett)


990 Ft. from N. Line

_____ Ft. from S. Line

_____ Ft. from E. Line

660 Ft. from W. Line

Elev. 1842

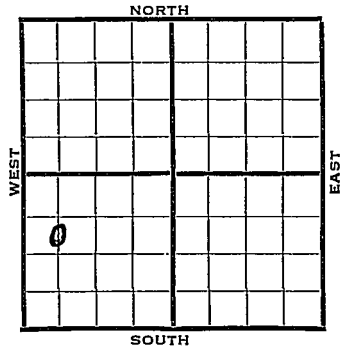

1940	REPORT
7/17	Location
7/25	"
8/2	15" - 22' Drlg. 1000'
8/8	Anhy 1098' 10" - 1107' Drlg. 2100'
8/14	Lans. 3104- Drlg. 3230'
8/21	Arb. 3332½' 7" - 3333' T.D. 3342' Echometer potential 31,114 bbls. Maximum 3000 bbls.

COMPLETED

Map No. _____ Sec. 18 Twp. 11 R. 17W

Well No. 4 Husted

Dickey Oil _____ Company

Contractor _____

FIRST REPORT

C S L NW SW

990 Ft. from N. Line

_____ Ft. from S. Line

_____ Ft. from E. Line

660 Ft. from W. Line

BURNETT POOL

SECTION PLAT

Location X _____

Rig up _____

Drilling and Remarks: _____

RECORD

Cased _____ in., _____ ft.

Sand _____

Gas _____

Oil _____

Total Depth _____

PRODUCTION

1st 24 hrs. Nat. _____

1st 24 hrs. after shot _____

Gas _____ Cu. Ft.

Dry Hole _____

Abandoned _____

Date

JUL 17 1940 19 S. J. LEWIS Scout

Map No. 71 Sec. 18 Twp. 11 R. 17W

Well No. 4 Husted

Dickey Oil

Company

Contractor

COMPLETE

C S L NW SW

990 Ft. from N. Line

_____ Ft. from S. Line

_____ Ft. from E. Line

660 Ft. from W. Line

SECTION PLAT

BURNETT POOL

Location _____

Rig up _____

Drilling and Remarks:

Cor & 3332 1/2

7" @ 3333

Echometer P.V.

31114

Max 3000

RECORD

Cased _____ in., _____ ft.

Sand _____

Gas _____

Oil _____

Total Depth 3342

PRODUCTION

1st 24 hrs. Nat. _____

1st 24 hrs. after shot _____

Gas _____ Cu. Ft.

Dry Hole _____

Abandoned _____

Date

AUG 21 1940 19

S. J. LEWIS Scout