


Section 18 Township 11 Range 17-W

Well No. #5 Husted

Company Dickey Oil

NORTH Bemis Pool

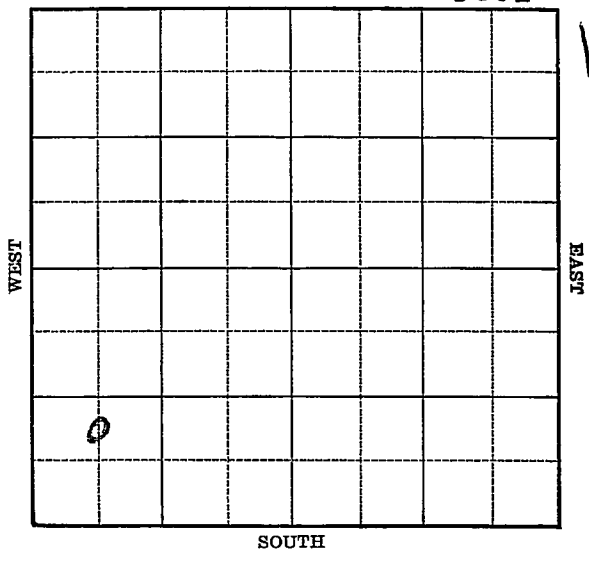

Sec. 18 Twp. 11 R. 17-W

Well No. #5 Husted Farm

Dickey Oil Company

(Bemis)


_____ Ft. from N. Line

990 Ft. from S. Line

_____ Ft. from E. Line

660 Ft. from W. Line

Elev. 1842
~~1888~~

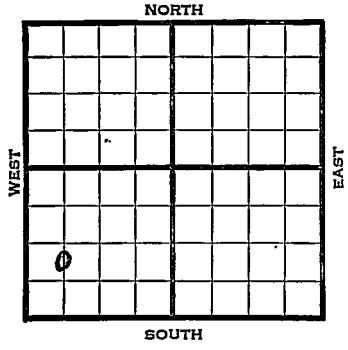

| 1940 | REPORT |
|-------|----------------------------------|
| 10/2 | Location |
| 10/10 | Derrick. |
| 10/17 | 15" - 36' Anhy. 1083-1111' |
| | Run csg. |
| 10/24 | 10" - 1100' Drlg. 2500' |
| 10/31 | Drlg. 3210' |
| | |
| 11/6 | Arb. 3331' |
| | 7" - 3331' |
| | T.D. 3343' |
| | Depthograph potential 3771 bbls. |
| | Maximum 3000 bbls. |
| | COMPLETED |
| | |
| | |
| | |
| | |
| | |
| | |
| | |
| | |

