

KANSAS

Ellis

Form 51-5M-7-40-Palace

Section 18 Township 11 Range 17-W

Well No. #6 Husted

Company Dickey

Bemis Pool

NORTH

13

WEST

EAST

SOUTH


0

Sec. 18 Twp. 11 R. 17-W

Well No. #6 Husted Farm
Dickey Company

(Bemis)

 Ft. from N. Line
330 Ft. from S. Line
 Ft. from E. Line
660 Ft. from W. Line
 Elev. 1871

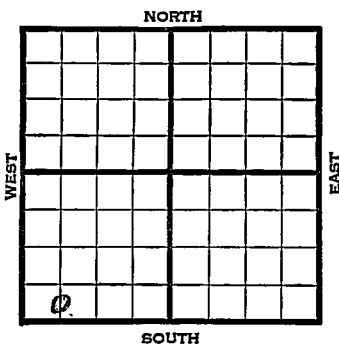

REPORT	
1940	
10/23	Location
10/31	7" - 1100' 2. 3500'
11/7	R.U.R.
11/14	10" - 1146' WOG.
11/21	Drlg. 2800'
11/27	Arb. 3357-59' T.D. 7" - 3358' S.O. RUST.
12/5	T.D. 3377' 2950' oil 5 hrs. 3000 acid.
12/11	Arb. 3357' 7" - 3358' T.D. 3377' 3000 acid. Echometer potential 1663 bbls. 33.5 Gravity
COMPLETED	

Map No. 77 Sec. 18 Twp. 11 R. 17WWell No. 6 HustedDickey Company

Contractor

FIRST REPORT

C S L SW SW

 Ft. from N. Line330 Ft. from S. Line Ft. from E. Line660 Ft. from W. Line

BEMIS POOL

SECTION PLAT

Location XRig up

Drilling and Remarks:

RECORDCased in., ft.Sand Gas Oil Total Depth **PRODUCTION**1st 24 hrs. Nat. 1st 24 hrs. after shot Gas Cu. Ft.Dry Hole Abandoned

Date

OCT 23 1940 19S. J. LEWIS Scout

Map No. 71 Sec. 18 Twp. 11 R. 17W

Well No. 6 Husted

Dickey Company

Contractor

COMPLETED

SECTION PLAT

C S L SW S W

 Ft. from N. Line

330 Ft. from S. Line

 Ft. from E. Line

660 Ft. from W. Line

BEMIS POOL

X			
o			

Location

Rig up

Drilling and Remarks:

Cor & 3357
7" C 3358
3000 Acid
Echo P & 1663
33.5 Gr

RECORD

Cased in., ft.

Sand

Gas

Oil

Total Depth 3327

PRODUCTION

1st 24 hrs. Nat.

1st 24 hrs. after shot

Gas Cu. Ft.

Dry Hole

Abandoned

Date

DEC 11 1940 19

S. J. LEWIS Scout