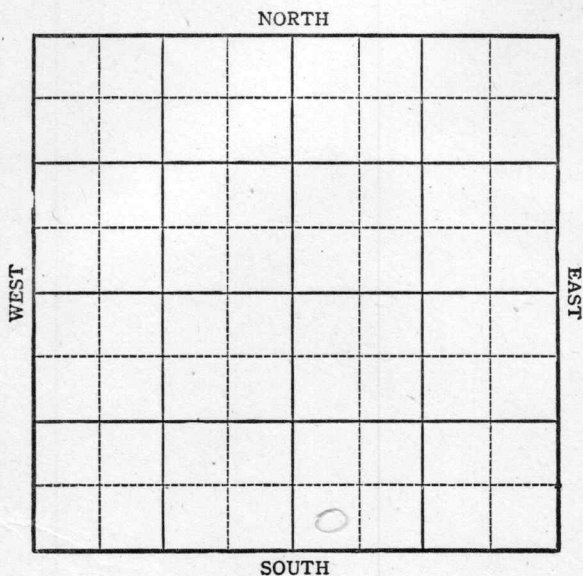


KANSAS

Ellis County

Section 18 Township 11 Range 20WWell No. #1 P. Olson*Huber*Company J. C. ~~Heiber~~ et al

KANSAS *Special* Ellis County

Sec. 18 Twp. 11 R. 20W

Well No. #1 P. Olson Farm

J. C. ~~Seiher~~ ^{Huber} et al Company


Wildcat

 Ft. from N. Line

330 Ft. from S. Line

 Ft. from E. Line

330 Ft. from W. Line

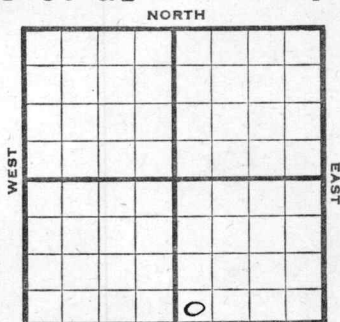

SW SE

Elev. 2156

R E P O R T

1944

10/18 Location

10/25 RUR

11/2 12" @ 152 WOO

11/8 Drlg. 2490

11/16 Anhy 1585

Topeka 3288

Lans 3458

Drlg. 3625'

11/22 BKC 3700

Cong 3772

Arb. 3899

TD 3915

ABANDONED

Pool Name Wildcat

KANSAS

Map No. 70 Sec. 18 Twp. 11 R. 20 W

Well No. 1 P. Olson

J. C. Heiber et al Company

FIRST REPORT

Contractor

SW SE

SECTION PLAT

 Ft. from N. Line

330 Ft. from S. Line

 Ft. from E. Line

330 Ft. from W. Line

Ellis County

Location X

Rig up

Drilling and Remarks:

Hot Hole

RECORD

Cased in., ft.

Sand

Gas

Oil

Total Depth

PRODUCTION

1st 24 hrs. Nat.

1st 24 hrs. after shot

Gas Cu. Ft.

Dry Hole

Abandoned

Date

OCT 1 8 1944 19

S. J. LEWIS

Scout

Pool Name WildcatMap No. 70 Sec. 18 Twp. 11 R. 20 WWell No. 1 P. OlsonJ. M. Huber et al

Company

ABANDONED

Contractor

SW SE

SECTION PLAT

 Ft. from N. Line330 Ft. from S. Line Ft. from E. Line330 Ft. from W. LineEllisLocation Rig up

Drilling and Remarks:

B/KC8700Dring 3772Re 48899

RECORD

Cased in., ft.Sand Gas Oil Total Depth 2915

PRODUCTION

1st 24 hrs. Nat. 1st 24 hrs. after shot Gas Cu. Ft.Dry Hole Abandoned

Date

NOV 22 194419S. J. LEWIS Scout