

KANSAS GEOLOGICAL SOCIETY
KANSAS WELL LOG BUREAU - KANSAS WELL SAMPLE BUREAU
KANSAS GEOLOGICAL SOCIETY BUILDING
508 EAST MURDOCK - WICHITA, KANSAS

COMPANY **BANKOFF & LEBEN**

SEC. 21 T. 11 R. 18W
 LOC. NE SW NW

FARM **Wasinger**

NO. 1

TOTAL DEPTH **3475**

COMM. **7-19-66**

COMP. **7-27-66**


BHDT OR TREATED

CONTRACTOR **Leben Drlg.**

ISSUED **10-1-66**

COUNTY **Ellis**

KANSAS

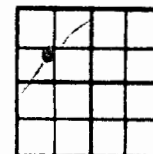

CASING

20	10	
15	8	5/8" @ 211' w/160 SX.
12	6	
13	5	

ELEVATION **1917'KB**


PRODUCTION **DRY (Arb)**

FIGURES INDICATE BOTTOM OF FORMATIONS

0	15	Surface Clay, Sand	
15	40	Sand	
40	211	Shale, Sand	SAMPLE TOPS:
211	675	Shale, Redbed	
675	890	Shale, Sand	Heebner 3118
890	1205	Redbed	Lansing 3159
1205	1210	Shale	Conglomerate 3408
1210	1241	Anhydrite	Simpson 3444
1241	1620	Shale	Arbuckle 3467
1620	1780	Shale, Shells	
1780	2355	Lime, Shale	
2355	2938	Shale, Lime	
2938	3025	Lime, Shale	
3025	3395	Lime	
3395	3430	Conglomerate	
3430	3460	Lime, Shale	
3460	3471	Lime	
3471	3475	Arbuckle	
	<u>3475</u>	<u>RTD - D. & A.</u>	

Set 8 5/8" surface casing @ 211' cemented with 160 sacks Common 2% cc

I, Doug Boyd, do hereby certify that the above and foregoing is a true and correct copy of the log of the Wasinger #1 well, located NE SW NW of Section 21, Township 11 South, Range 18 West, Ellis County, Kansas, as reflected by the records of Leben Drilling, Inc.

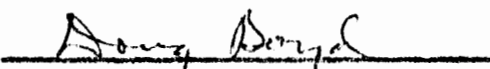
 Doug Boyd

STATE OF KANSAS)
) cc