OPERATOR Murfin Drilling Company

ADDRESS 617 Union Center, Wichita, Kansas

Distributed By
KANSAS GEOLOGICAL SOCIETY
~~508 East Murdock~~
WICHITA, KANSAS 67214

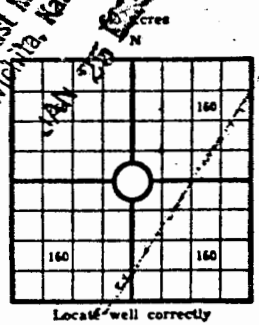

Locate well correctly

COUNTY Ellis, SEC. 26, TWP. 11s, RGE. 18w

COMPANY OPERATING Murfin Drilling Co.

OFFICE ADDRESS 617 Union Center, Wichita

DRILLING STARTED 12/17/68, 19__, DRILLING FINISHED 12/31/68, 19__

DATE OF FIRST PRODUCTION _____ COMPLETED _____

WELL LOCATED SE ¼ NW ¼ SE ¼, North of South Line and _____ ft. East of West Line of Quarter Section

Elevation (Relative to sea level) DERRICK FLOOR 2109 GROUND 2106

CHARACTER OF WELL (Oil, gas or dryhole) Dryhole

OIL OR GAS SANDS OR ZONES

Name	From	To	Name	From	To
1			4		
2			5		
3			6		

Perforating Record If Any / Shot Record

Formation	From	To	No. of Shots	Formation	From	To	Size of Shot

CASING RECORD

Amount Set								Amount Pulled		Packer Record	
Size	Wt.	Thds.	Make	Ft.	In.	Ft.	In.	Size	Length	Depth Set	Make

Liner Record: Amount _____ Kind _____ Top _____ Bottom _____

CEMENTING AND MUDDING

Size	Amount Set Ft.	Amount Set In.	Sacks Cement	Chemical Gal.	Chemical Make	Method of Cementing	Amount	Mudding Method	Results (See Note)
8 5/8"	183'		150 sx. cement						

Note: What method was used to protect sands if outer strings were pulled? _____

NOTE: Were bottom hole plugs used? _____ If so, state kind, depth set and results obtained _____

TOOLS USED

Rotary Tools were used from 0 feet to R.T.D. Cable tools were used from _____ feet to _____ feet, and from _____ feet to _____ feet, and from _____ feet to _____

Type Rig Rotary

INITIAL PRODUCTION TEST

Describe initial test: whether by flow through tubing or casing or by pumping _____

Amount of Oil Production _____ bbls. Size of choke, if any _____ Length of test _____ Water Production _____ bbls. Gravity of oil _____ Type of Pump if pump is used, describe _____

FORMATION RECORD

Give detailed description, thickness of all formation drilled through, contents of sand, whether dry, water, oil or gas.

Formation	Top	Bottom	Formation	Top	Bottom
Surface		183			
Shale	183	525			
Sand shale	525	880			
Sand	880	1050			
Shale shells	1050	1280			
Redbed	1280	1386			
Anhydrite	1386	1417			
Shale shells	1417	2270			
Shale lime	2270	2285			
Lime shale	2285	2505			
Shale lime	2505	3152			
Lime shale	3152	3430			
Lime	3430	3610			
Lime shale	3610	3710			
Rotary T.D.	3710'				

I, the undersigned, being first duly sworn upon oath, state that this well record is true, correct and complete according to the records of this office and to the best of my knowledge and belief.

John D. Murfin
Name and title of representative of company
President

Subscribed and sworn to before me this 3rd. day of January, 19__

My Commission expires 2/15/71

Helen Carlson
Notary Public
Helen Carlson

26-11-18w

NAME Jacobs-Peavey WELL NO. 1 COUNTY Ellis SEC. 26 TWP. 11s RGE. 18w

KANSAS GEOLOGICAL SOCIETY 508 East Murdock Wichita, Kansas