

29-11-NW

CO-7
(Revised)

PLAT AND CERTIFICATION OF ACREAGE ATTRIBUTABLE TO AN OIL WELL

State Corporation Commission, Conservation Division
200 Colorado Derby Bldg. Wichita, Kansas 67202

OPERATOR CHAMPLIN PETROLEUM COMPANY

LOCATION OF WELL: C SW NW NW

LEASE Johnson "A"

4290 feet from the South line

4950 feet from the East line

WELL NUMBER 11

Of the _____ of Sec 29 T. 11S R. 18W

FIELD Riverview



COUNTY Ellis

*NUMBER OF ACRES
ATTRIBUTABLE TO WELL 10

DESCRIPTION OF ACREAGE: SW/4 NW/4 NW/4

P L A T

(Show location of Well and outline attributable acreage)
(Show footage to nearest lease or unit boundry line)

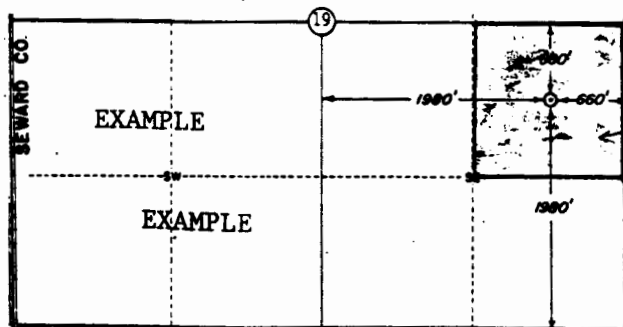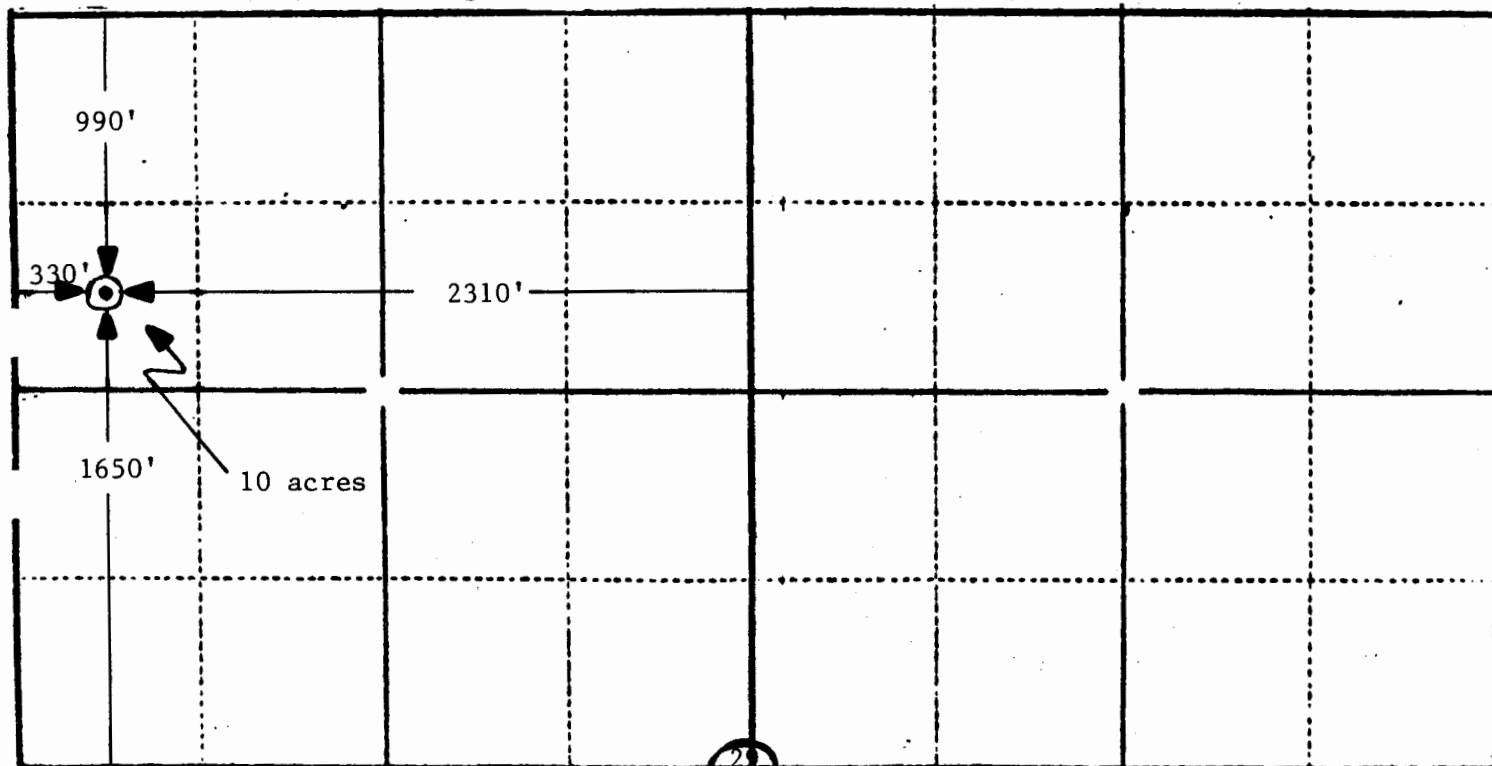

STATE CORPORATION COMMISSION

FEB 2 1967

CONSERVATION DIVISION
Wichita, Kansas