

29-11-18W

STATE CORPORATION COMMISSION OF KANSAS
OIL & GAS CONSERVATION DIVISION
WELL COMPLETION OR RECOMPLETION FORM
ACO-1 WELL HISTORY
DESCRIPTION OF WELL AND LEASE

Operator: License # 6417
Name Champlin Petroleum Company
Address 1400 Smith Street, Suite 1500
Houston, TX 77002
City/State/Zip

Purchaser Koch Oil

Operator Contact Person Marilyn Day
Phone (713) 654-2758

Contractor: License # 6033
Name Murfin Drilling Company

Wellsite Geologist N/A
Phone

Designate Type of Completion

☒ New Well ☐ Re-Entry ☐ Workover
☒ Oil ☐ SWD ☐ Temp Abd
☐ Gas ☐ Inj ☐ Delayed Comp.
☐ Dry ☐ Other (Core, Water Supply etc.)

If ONWO: old well info as follows:

Operator
Well Name
Comp. Date Old Total Depth

WELL HISTORY

Drilling Method:

☒ Mud Rotary ☐ Air Rotary ☐ Cable

1/20/87 1/25/87 2/17/87
Spud Date Date Reached TD Completion Date

3750' 3588'
Total Depth PBTD

8-5/8" @ 258'
Amount of Surface Pipe Set and Cemented at...feet
Multiple Stage Cementing Collar Used? ☒ Yes ☐ No
If yes, show depth set...1395...feet
If alternate 2 completion, cement circulated
from...3707...feet depth to...0...w/...530...SX cmt
Cement Company Name BJ Titan
Invoice #

API NO. 15-051-24,459

County Ellis

SW NE NW Sec. 29 Twp. 11S Rge. 18 East
West

4270 Ft North from Southeast Corner of Section
3785 Ft West from Southeast Corner of Section

(Note: Locate well in section plat below)


Lease Name Johnson "A" Well # 12

Field Name Riverview

Producing Formation Lansing/KC & Topeka

Elevation: Ground 2069' KB 2074'

Section Plat

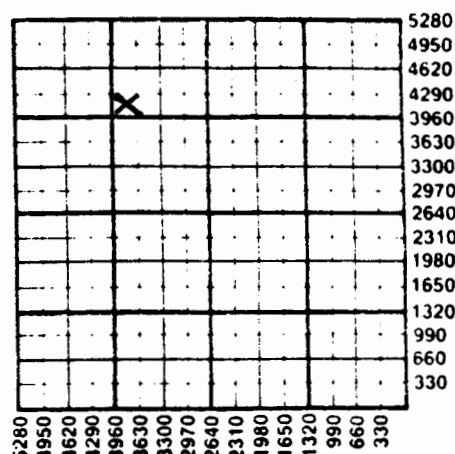

WATER SUPPLY INFORMATION

Disposition of Produced Water: ☒ Disposal
Docket # D-20,231: ☐ Repressuring
D-19,691; D-22,257

Questions on this portion of the ACO-1 call:

Water Resources Board (913) 296-3717

Source of Water:

Division of Water Resources Permit #

Groundwater...Ft North from Southeast Corner
(Well) ...Ft West from Southeast Corner of
Sec Twp Rge East West

Surface Water...Ft North from Southeast Corner
(Stream, pond etc)...Ft West from Southeast Corner
Sec Twp Rge East West

☒ Other (explain) Dorvan Connell, 107 W. 33rd,
Hays, KS 67601 (purchased from city, R.W.D. #)

Estimated Production Per 24 Hours	Oil	Gas	Water	Gas-Oil Ratio	Gravity
	28 Bbls	0 MCF	86 Bbls	- CFPB	29.4°

One copy of all wireline logs and driller's time log shall be attached with all plugged wells. Submit CP-111 form with all temporarily abandoned wells.

W8A-M-92

SIDE TWO

85857

Operator Name Champlin Petroleum Company Lease Name Johnson "A" Well # 12

Sec 29 Twp 11S Rge 18 ☐ East
☒ West County Ellis

WELL LOG

INSTRUCTIONS: Show important tops and base of formations penetrated. Detail all cores. Report all drill stem tests giving interval tested, time tool open and closed, flowing and shut-in pressures, whether shut-in pressure reached static level, hydrostatic pressures, bottom hole temperature, fluid recovery, and flow rates if gas to surface during test. Attach extra sheet if more space is needed. Attach copy of log.

Drill Stem Tests Taken ☐ Yes ☒ No
 Samples Sent to Geological Survey ☒ Yes ☐ No
 Cores Taken ☐ Yes ☒ No

Formation Description

☒ Log ☐ Sample

Name Top Bottom

Topeka 3043'
 Heebner 3270'
 Lansing/KC 3311'
 Arbuckle 3599'

METHOD OF COMPLETION

Disposition of gas: ☐ Vented ☐ Open Hole ☒ Perforation
☐ Sold ☐ Other (Specify)
☐ Used on Lease ☐ Dually Completed
☒ Commingled

Production Interval

Lansing/KC 3346-3490'
 U. Topeka 3071-80'
 L. Topeka 3233-40'

CASING RECORD ☒ New ☐ Used

Report all strings set-conductor, surface, intermediate, production, etc.

Purpose of String	Size Hole Drilled	Size Casing Set (in O.D.)	Weight Lbs/Ft.	Setting Depth	Type of Cement	#Sacks Used	Type and Percent Additives
...Surface.....	...12-1/4"	...8-5/8"	...24#	...258'	Class A	...200	2% gel, 3% cc
...Production...	...7-7/8"	...5-1/2"	...14 & 17#	...3749'	50-50 Poz	...220	...
					50-50 Poz	310	...

PERFORATION RECORD

Shots Per Foot	Specify Footage of Each Interval Perforated	Acid, Fracture, Shot, Cement Squeeze Record (Amount and Kind of Material Used)	Depth
4	M. Arbuckle 3638-46'	4000 gal 15% HCl	3071-3490'
4	U. Arbuckle 3608-18'	4000 gal 15% HCl	3071-3490'
4	LKC 3346-3490'		
4	L. Topeka 3233-40'		
4	U. Topeka 3071-80'		

TUBING RECORD

Size Set At Packer at Liner Run ☐ Yes ☒ No
 2-7/8" 3560' CIBP - 3600'

Date of First Production | Producing Method

2/19/87

☐ Flowing ☒ Pumping ☐ Gas Lift ☐ Other (explain).....