

# KANSAS DRILLERS LOG

API No. 15 — 051 — 21,894  
County Number

Operator

**Champlin Petroleum Co.**

Address

**2601 N.W. Expressway, Suite 800E, Oklahoma City, OK 73112**

Well No.

**7**

Lease Name

**Johnson B**

Footage Location

**1650**

feet from (N) (S) line

**1090**

feet from (E) (W) line

Principal Contractor

**Red Tiger Drilling**

Geologist

Spud Date

**6/20/80**

Total Depth

**3726**

P.B.T.D.

**2688**

Date Completed

**8/22/80**

Oil Purchaser


**Koch**

S. 29 T. 11 R. 18 K  
W

Loc. 100' E C SE NW SW

County ELLIS

640 Acres  
N

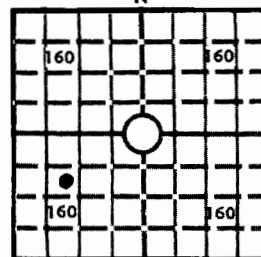

Locate well correctly

Elev.: Gr.

**2063**

DF KB **2068**

## CASING RECORD

Report of all strings set—surface, intermediate, production, etc.

Purpose of string	Size hole drilled	Size casing set (in O.D.)	Weight lbs/ft.	Setting depth	Type cement	Sacks	Type and percent additives
Surface	12 1/4"	8 5/8"	24#	257	Quickset	200	
Production	7 7/8"	5 1/2"	14#	3723	50-50 Poz.	200	18% Salt-.75% CFR-2
					Howco Lite	400	5# Gil./SK

## LINER RECORD

Top, ft.	Bottom, ft.	Sacks cement
----------	-------------	--------------

## PERFORATION RECORD

Top, ft.	Bottom, ft.	Sacks cement	Shots per ft.	Size & type	Depth interval
			2	DP Jet	3634-40
			2	.47"	3602-3612
Size	Setting depth	Packer set at			
2 7/8"	3667				


## ACID, FRACTURE, SHOT, CEMENT SQUEEZE RECORD

Amount and kind of material used	Depth interval treated
-none-	

## INITIAL PRODUCTION

Date of first production		Producing method (flowing, pumping, gas lift, etc.)			
8/22/80		Pumping			
RATE OF PRODUCTION PER 24 HOURS	Oil	Gas	Water	Gas-oil ratio	
	36	bbls.	MCF	360	bbls.
Disposition of gas (vented, used on lease or sold)			Producing interval(s)		
Vented			3634-40, 3602-12		

INSTRUCTIONS: As provided in KCC Rule 82-2-125, within 90 days after completion of a well, one completed copy of this Drillers Log shall be transmitted to the State Geological Survey of Kansas, 4150 Monroe Street, Wichita, Kansas 67209. Copies of this form are available from the Conservation Division, State Corporation Commission, 3830 So. Meridian (P.O. Box 17027), Wichita, Kansas 66217. Phone AC 316-522-2206. If confidential custody is desired, please note Rule 82-2-125. Drillers Logs will be on open file in the Oil and Gas Division, State Geological Survey of Kansas, Lawrence, Kansas 66044.
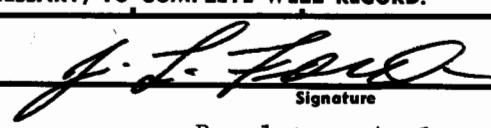
<b>Operator</b> Champlin Petroleum Co.		<b>DESIGNATE TYPE OF COMP.: OIL, GAS, DRY HOLE, SWDW, ETC.:</b>	
<b>Well No.</b> 7	<b>Lease Name</b> Johnson "B"		Single Oil Well
<b>S 29 T 11 R 18 W</b> 100' E. C. SE. N.W. S.W.			
<b>WELL LOG</b> <small>Show all important zones of porosity and contents thereof; cored intervals, and all drill-stem tests, including depth interval tested, cushion used, time tool open, flowing and shut-in pressures, and recoveries.</small>			<b>SHOW GEOLOGICAL MARKERS, LOGS RUN, OR OTHER DESCRIPTIVE INFORMATION.</b>
<b>FORMATION DESCRIPTION, CONTENTS, ETC.</b>	<b>TOP</b>	<b>BOTTOM</b>	<b>NAME</b>
<div style="display: flex; justify-content: space-between;"> <div style="width: 45%;"> <p><u>-Logs-</u></p> <p>Acoustic Velocity                      2800                      3720</p> <p>Radiation - Guard Log                0                        3718</p> <p><u>-Drillers Log-</u></p> <p><u>FORMATION</u></p> <p>Lime &amp; Limes                            0                        103</p> <p>Post Rock                                103                     106</p> <p>Shale, Lime &amp; Post Rock               106                     120</p> <p>Shale                                       120                     258</p> <p>Shale &amp; Lime Stone                    258                     630</p> <p>Sand                                        630                     650</p> <p>Shale                                       650                     690</p> <p>Sand                                        690                     730</p> <p>Shale                                       730                     861</p> <p>Sand                                        861                     1064</p> <p>Shale                                       1064                    1386</p> <p>Anhydrite                                1386                    1413</p> <p>Shale                                       1413                    2244</p> <p>Lime                                        2244                    2280</p> <p>Shale                                       2280                    2445</p> <p>Shale &amp; Lime                            2445                    3205</p> <p>Lime                                        3205                    3565</p> <p>Arbuckle                                 3565                    3726</p> <p>RTD                                        3726</p> </div> <div style="width: 50%; border-left: 1px solid black; padding-left: 10px;"> <p style="text-align: center;"><u>FROM</u></p> <p style="text-align: center;"><u>TO</u></p> </div> </div>			
USE ADDITIONAL SHEETS, IF NECESSARY, TO COMPLETE WELL RECORD.			
<b>Date Received</b>	<div style="text-align: center;">             Signature            Regulatory Analyst            Title            1/8/81            Date         </div>		

08898