

KANSAS


Ellis

Section 19 Township 11 Range 16W

Well No. 4 Potter

Company Huber et al

Bemis
NORTH

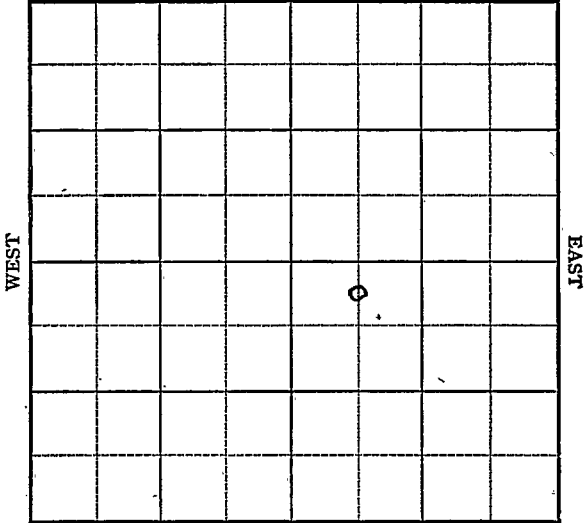

SOUTH

KANSAS Ellis

Sec. 19 Twp. 11 R. 16W

Well No. #4 Potter Farm

Huber et al Company


Bemis Pool (Huber, Cont.)

330' Ft. from N. Line

Ft. from S. Line

Ft. from E. Line

660' Ft. from W. Line

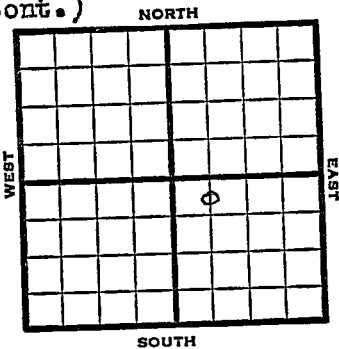

C N L NW SE

1949

Elev. 1862' REPORT

5/25

Location

6/1

8" @ 1040'

6/7

Heebner 3023'

Lansing 3072'

Drlg. 3138'

6/15

Simpson sand 3373'

Arb. 3382'

TD 3463'

5" @ 3463'

6/21

"

6/28

12 shots 3386-90 200 acid

Swb 4 bbls oil PH \neq 10% W

7/6

"

7/12

"

7/20

"

7/27

Arb 3382'

5" @ 3463'

Perf.

500 acid

Pump 77 oil & 9% W Pot.

Gr. 36°

TD 3463'

COMPLETED

Map No. _____ Sec. 19 Twp. 11 R. 16W

Well No. 4 Potter

Huber et al. Company

Huber Contractor

C N L NW SE

**FIRST REPORT
SECTION PLAT**

330 Ft. from N. Line

_____ Ft. from S. Line

_____ Ft. from E. Line

660 Ft. from W. Line

		6	

Ellis County

Location X

Rig up _____

Drilling and Remarks:

RECORD

Cased _____ in., _____ ft.

Sand _____

Gas _____

Oil _____

Total Depth _____

PRODUCTION

1st 24 hrs. Nat. _____

1st 24 hrs. after shot _____

Gas _____ Cu. Ft.

Dry Hole _____

Abandoned _____

Date

MAY 25 1949 19

S. J. LEWIS

Scout

