


Section 19 Township 11 Range 16 W

Well No. ~~#1~~<sup>6</sup> Potter

Company Okmar

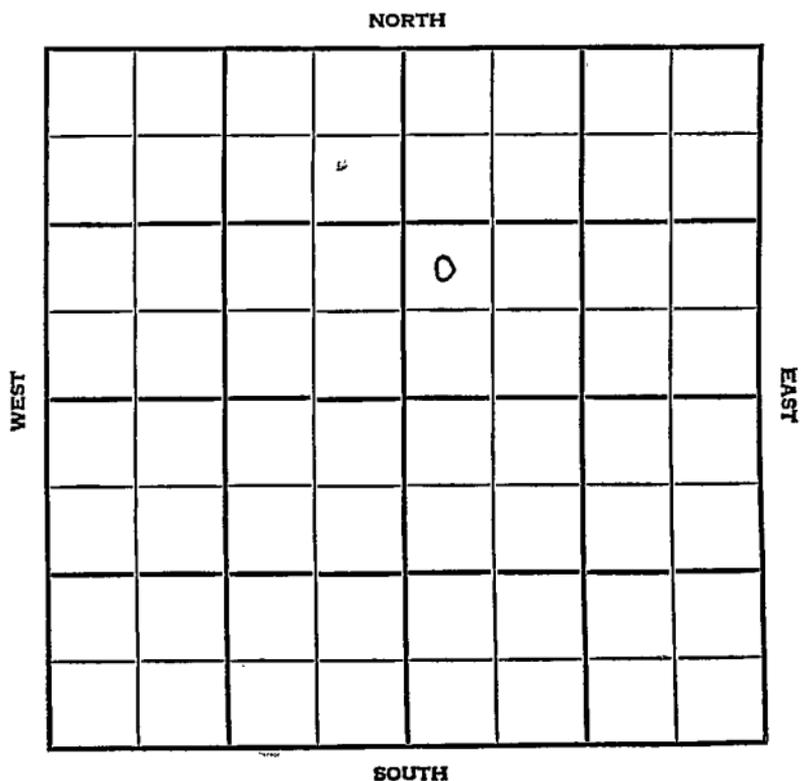

Ellis

KANSAS

SEC.	TWP.	R..
19	11	16W

WELL NO. ~~#6~~  
~~#1~~ Potter

FARM

COMPANY  
 Okmar


CONTRACTOR  
 Garvey  
 Bemis-Shutts

\_\_\_\_\_ Ft. from N. Line

990 \_\_\_\_\_ Ft. from S. Line

\_\_\_\_\_ Ft. from E. Line

330 \_\_\_\_\_ Ft. from W. Line

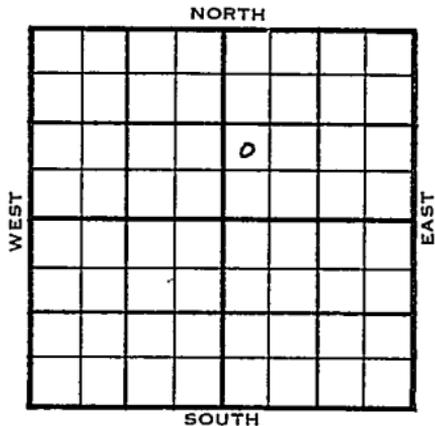

NW SW NE

1955	ELEVATION 1864'	REPORT
------	--------------------	--------

10/12 Comm 10-9-55  
 10" @ 620  
 Drlg 1050

11-16 DST 2800-15, op 1 hr. rec 2250' msw  
 5 1/2" @ 3373/125  
 DB 3377  
 P/ 25 bopd 75% wtr.,  
 Comp.  
 Tops: Anh. 1040  
       Tp. 2775  
       H. 3012'  
       Tr. 3034  
       L. 3057  
 Marm 3282  
 C. 3331'  
       S. 3350  
       Shly 3366  
       S-lid arb. 3372  
 TD 3375'

COMPLETED

# SCOUT TICKET DX-201

SEC. 19 TWP. 11 R. 16W

WELL NO. 6 Potter FARM

COMPANY Okmar CONTRACTOR

## CORRECTION


NW SW NE

\_\_\_\_\_ FT. FROM N. LINE

990 FT. FROM S. LINE

\_\_\_\_\_ FT. FORM E. LINE

330 FT. FROM W. LINE

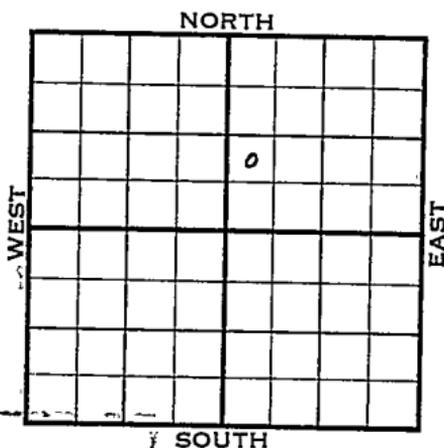

~~Ellis County~~

LOCATION  
 RIG UP  
 DRILLING AND REMARKS:

Reported  
 #1 Potter

RECORD

CASED IN., FT.

SAND

GAS

OIL

TOTAL DEPTH

PRODUCTION

1ST 24 HRS. NAT.

1ST 24 HRS. AFTER SHOT

GAS CU. FT.

DRY HOLE

ABANDONED

DATE NOV 16 1955 SCOUT

# SCOUT TICKET

DX-201

SEC.

19

TWP.

11

R.

16W

WELL NO.

6 Potter

COMPANY

FARM

Okmar

CONTRACTOR

## CORRECTION


NW SW NE

\_\_\_\_\_ FT. FROM N. LINE

990 FT. FROM S. LINE

\_\_\_\_\_ FT. FORM E. LINE

330 FT. FROM W. LINE

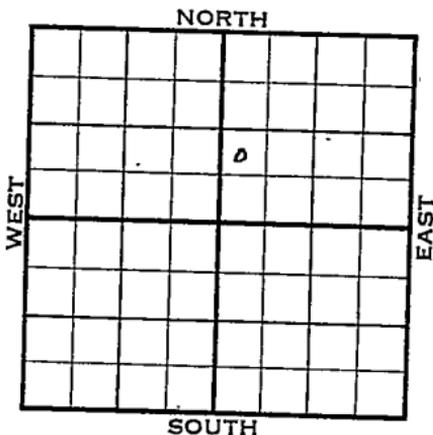

Ellis County

LOCATION  
 RIG UP  
 DRILLING AND REMARKS:

Reported  
 #1 Potter

RECORD

CASED IN., FT.  
 SAND  
 GAS  
 OIL

PRODUCTION

TOTAL DEPTH  
 1ST 24 HRS. NAT.  
 1ST 24 HRS. AFTER SHOT  
 GAS CU. FT.  
 DRY HOLE  
 ABANDONED

DATE

OCT 19 1955

SCOUT

*L. J. Harris*



County W. Wis Elev. 1864  
 Sec. 19 Twp. 11 Rge. 16W  
 Company Okmar  
 Farm Name Potter No. 6

Co.

TOPS	DEPTH	LOG	DATUM
Anh.	1040		
Tp.	2775		911
H.	3012		1148
Tr.	3034		1170
Dg.			
Bl.			
L.	3057		1193
K.C.			
B.K.C.			
Ce. <u>norm</u>	3287		1418
C.	3331		1467
M.			
M.			
K.			
Mz.			
Me.			
V.			
S.	3350		1486
S.			
A. <u>shls</u>		3366	1502
R. <u>solid shls</u>		3372	1508
PE.			
G.			
T.D.	3375		


Loc. in Sec. NW SW NE

Geol. \_\_\_\_\_

Contr. Garvey

Pool \_\_\_\_\_

Bemis-Shutt

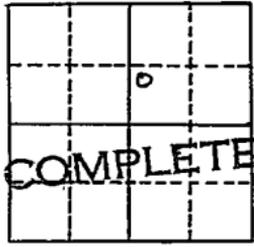

COMPLETE

Lse.

No.

Sec.

T.

R.

Date Comm. 10-9-55 NOV 16 1955

10" @ 620 DST 2800-15 open 1 hr.

rec. 2250' msw 5 1/2" @ 3373/125 DD 3 377

P/25 bopd 75% wtr. Comp.