


Ellis

KANSAS

SECTION 19 TOWNSHIP 11 RANGE 16 W

WELL NO. #7 Potter

COMPANY Okmar

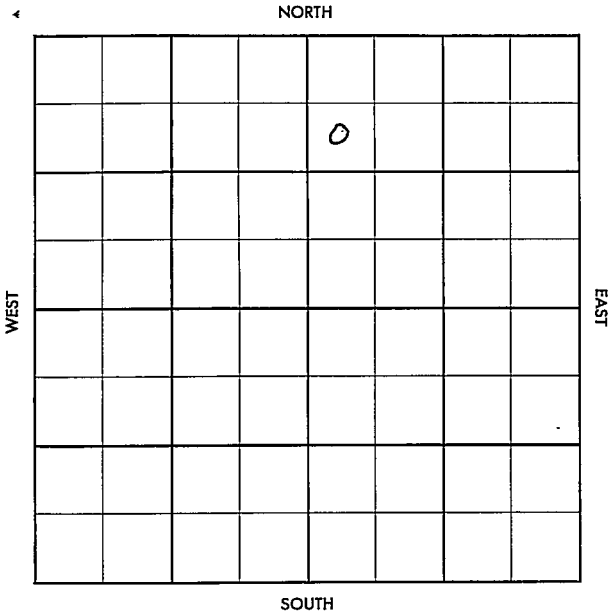

Ellis

KANSAS

SEC.

TWP.

R.

19

11

16W

WELL NO.

#7 Potter

COMPANY

FARM

Okmar

CONTRACTOR

Garvey

Bemis-Shutts


_____ Ft. from N. Line

_____ Ft. from S. Line

_____ Ft. from E. Line

_____ Ft. from W. Line

SW NW NE

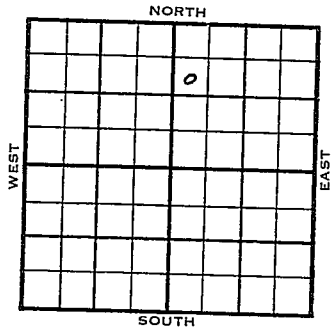

1955

ELEVATION

1833'

REPORT

11/2

RUR

11-30

Comm. 11-2-55
 8 5/8" @ 315
 5 1/2" @ 3348
 CO to 3350
 S/ 25 BOPD, 90% wtr.
 Comp. 25 BOPD, 90%
 Anh. 1010'
 Howard 2742
 Top 2769'
 Heeb 2939'
 Tor 3012
 KC 3036'
 C. 3310'
 Sh. 3324
 Sd 3341
 A 3347
 TD 3350'

COMPLETED

County

~~EM~~is

Elev.

Sec.

19

Twp.

11

Rge.

NOW

Company

~~OK~~ar

Farm Name

Potter

No.

7

Co.
Lse.
No.
Sec.
T.
R.

TOPS	DEPTH	LOG	DATUM
Anh.			
Tp.			
H.			
Tr.			
Dg.			
Bl.			
L.			
K.C.			
B.K.C.			
Ce.			
C.			
M.			
M.			
K.			
Mz.			
Ma.			
V.			
S.			
S.			
A.			
R.			
Pe.			
G.			
TD.			

Loc. in Sec.

SW NW NE

Geol.

Contr.

Garvey

Pool

Bemis-Shutte

FIRST REPORT

NOV 2 '55

Date Comm.

RUR

County Ellis Elev. 1833
 Sec. 19 Twp. 11 Rge. 16W
 Company Okmar Oil
 Farm Name Potter No. 7

TOPS	DEPTH	LOG	DATUM
Ann.	1010		
Tp. <u>Howard</u>	2742		909
H. <u>Top</u>	2769		936
Tr. <u>Well</u>	2989		1156
Dg. <u>Top</u>	3012		1179
Bl.			
L.			
K.C.	3036		1203
B.K.C.			
Sc.			
C.	3310		1477
M.			
M.			
K.			
Mz.			
Mo.			
V.			
S. <u>sh</u>	3324		1491
S. <u>sd</u>	3341		1508
A.	3347		1514
R.			
PE.			
G.			
T.D.	3350		

Loc. in Sec. SW NW NE
 Geol. _____
 Contr. _____
 Pool Bemis-Shutts

	0		
COMPLETE			

Date Comm. 11-2-55 NOV 3 0 1955
8 5/8" @ 315 5 1/2" @ 3348 CO to 3350
S/ 25 bond 90% wtr. Comp. 25 bond 90%

Co.
 Lse.
 No.
 Sec.
 T.
 R.