


DX 78-1 Ellis

KANSAS

Section 19 Township 11 Range 16W

Well No. #9 Potter

Company Okmar

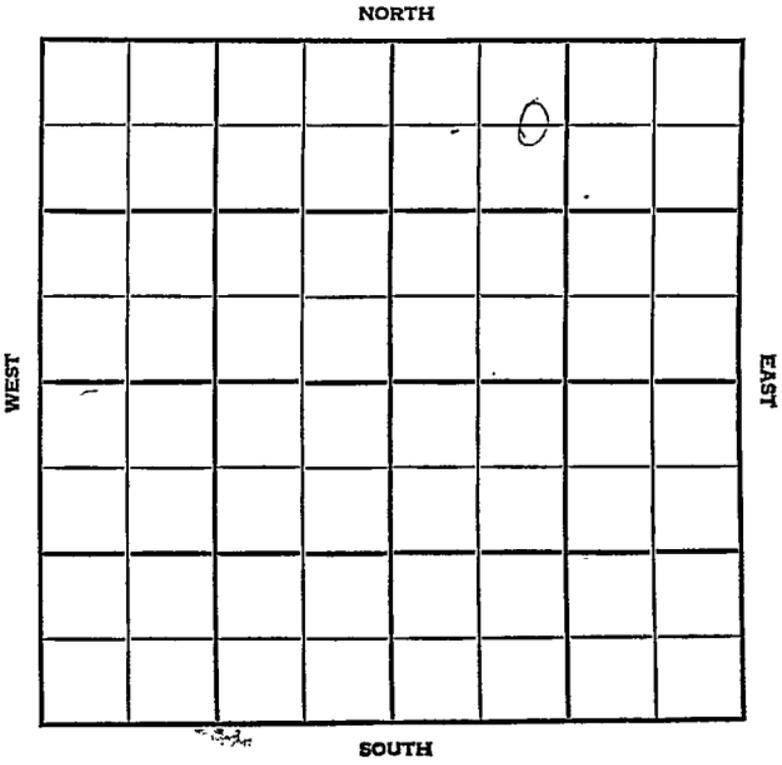

Ellis

KANSAS

SEC. 19 TWP. 11 R. 16W

WELL NO. #9 Potter FARM

COMPANY Okmar

CONTRACTOR Sierra

Bemis-Shutts


_____ FT. FROM N. LINE

_____ FT. FROM S. LINE

_____ FT. FROM E. LINE

_____ FT. FROM W. LINE

C E 1/2 NW NE

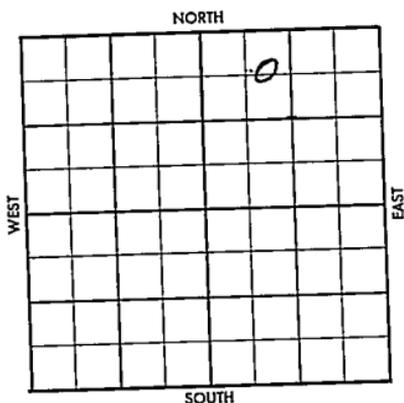

1956 ELEVATION 1833 REPORT

6-6 Comm. 5-30-56
 8" @ 1032

6-27 Drlg. 2915
 RTD 3714
 5 1/2" @ 3592/300 SWDW
 co 3714 input 660 BW in 21"
 DD @ 3715
 DD 3746
~~SSWD~~ Well
 Anz. 1021; H. 3020; Tr. 3042; L. 3065;
 A. 3585
 TD. 3714

ABANDONED

 Sec. 19 Twp. 11 Rge. 16W
 Company Okmar
 Farm Name Porter No. 9

TOPS	DEPTH	LOG	DATUM
Anh.			
Tr.			
H.			
Tr.			
Dg.			
Bl.			
L.			
K.C.			
B.K.C.			
Ce.			
C.			
M.			
M.			
K.			
Mz.			
Ma.			
V.			
S.			
S.			
A.			
R.			
PE.			
G.			
TR.			

Loc. in Sec. C E 1/2 NW NE

Geol. _____
 Contr. Sierra

Pool Bemis-Shutt

		0
FIRST REPORT		
JUN 6 '56		

Date Comm. 5-30-56
8" @ 1032 d rlg. 2915

OKMAR

65

Co.

Sec.

T No.

Sec.

T.

R.

 Sec. 19 Twp. 11 Rge. 1SW
 Farm Name Polter No. 9

TOPS	DEPTH	LOG	DATUM	Loc. in Sec.
Anh.	<u>1021</u>			<u>C 1/2 NW NE</u>
Tr.				
H.	<u>3020</u>			
Tr.	<u>3042</u>			
Dg.				
Bl.				
L.	<u>3065</u>			
K.C.				Geol.
B.K.C.				Contr.
Ce.				<u>Sierra</u>
C.				
M.				Pool
M.				<u>Bemic-Shutts</u>
K.				
Mz.				
Mo.				
V.				
S.				
S.				
A.	<u>3585</u>			<u>Abandoned</u> COMPLETE
R.				
PE.				
G.				
TD.	<u>3714</u>			

Date Comm. 5-30-56 JUN 27 '56
8" C. 1032 drl. 2915 JUN 13 '56

RTD 3714 5 1/2" 3592/300
SWDW JUN 20 '56 CO 3714 in pot
60 BW in 21" DD @ 3715
JUN 27 '56 DD 3746 TP complete
25 SWD Well