

KANSAS


Ellis

FORM 51 5M 4-41 PETROL

Section 19 Township 11 Range 16-W


Well No. #1 Slimmer

Company Sinclair-Prairie

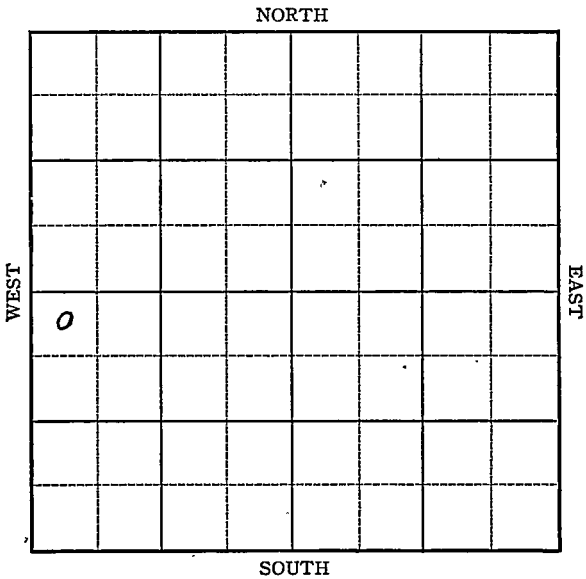

Sec. 19 Twp. 11 R. 16-WWell No. #1 Slimmer FarmSinclair-Prairie Company
(Bemis)330 Ft. from N. Line Ft. from S. Line Ft. from E. Line330 Ft. from W. Line

Elev. 1884

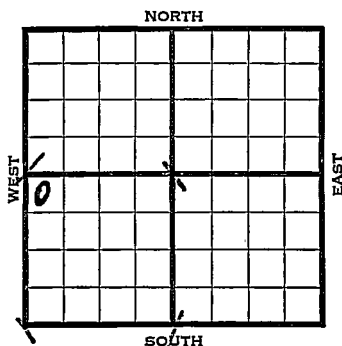

1941	REPORT
6/25	R.O.G.
7/3	Derrick.
7/10	"
7/17	Surface hole.
7/24	10" @ 1044 Drlg 2361
7/31	Arb 3369 $\frac{1}{2}$ -71 TD
	5" @ 3369 $\frac{1}{2}$ RUST
8/7	Arb 3373 $\frac{1}{2}$ Corrected 5" @ 3366 TD
	3375' 40' liner to 3375'.
8/15	Shut down
8/20	Arb. 3373 $\frac{1}{2}$ '
	5" - 3366'
	T.D. 3375'
	Echometer potential 3881 bbls.
	Maximum 3000 bbls.
	33.5 Gravity
	COMPLETED

Map No. 71 Sec. 19 Twp. 11 R. 16WWell No. 1 SlimmerSinclair Prairie Company

Contractor

FIRST REPORT

NW SW


330 Ft. from N. Line

Ft. from S. Line

Ft. from E. Line

330 Ft. from W. Line

SECTION PLAT

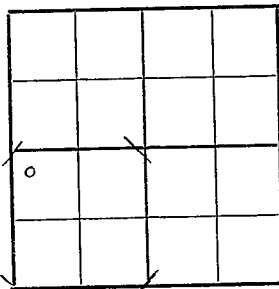

BEMIS POOL

Location _____

Rig up _____

Drilling and Remarks:

ROG

RECORD

Cased _____ in., _____ ft.

Sand _____

Gas _____

Oil _____

Total Depth _____

PRODUCTION

1st 24 hrs. Nat. _____

1st 24 hrs. after shot _____

Gas _____ Cu. Ft.

Dry Hole _____

Abandoned _____

Date

JUN 25 1941

19

S. J. LEWIS Scout

Map No. 7/ Sec. 19 Twp. 11 R. 16WWell No. 1 SlimmerSinclair Prairie

Company

COMPLETED

Contractor

NW SW

330 Ft. from N. Line Ft. from S. Line Ft. from E. Line330 Ft. from W. Line

SECTION PLAT

0			

BEMIS POOL

RECORD

Location Cased in., ft.Rig up Sand

Drilling and Remarks:

Gas Oil Total Depth 3325

PRODUCTION

1st 24 hrs. Nat. 1st 24 hrs. after shot Gas Cu. Ft.Dry Hole Abandoned

Cor 8373 1/2
5" 83366
Ech 8373 1/2
Max 8000

335 Gr.

Date

AUG 20 1941

19

S. J. LEWIS Scout