

KANSAS


FORM 51 5M 4-41 PETROL

Ellis

Section 19 Township 11 Range 16-W

Well No. #2 Slimmer

Company Sinclair-prairie

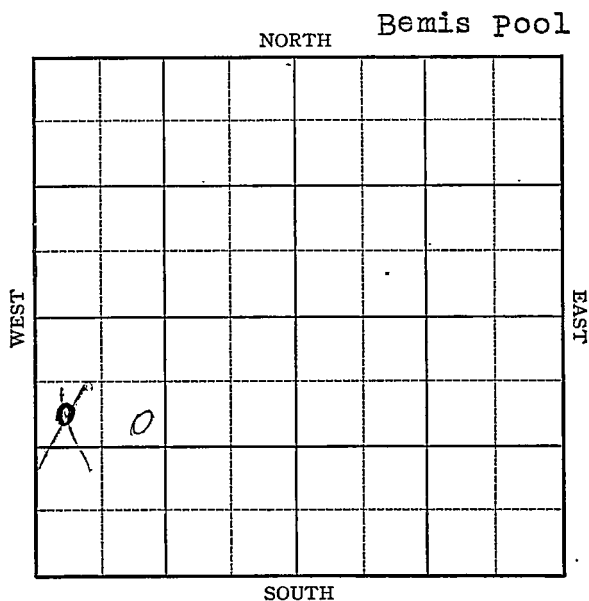

KANSAS


Ellis

Sec. 19 Twp. 11 R. 16-WWell No. #2 Slimmer Farm
Sinclair-Prairie Company

(Bemis)

990 Ft. from N. Line Ft. from S. Line Ft. from E. Line990
~~330~~ Ft. from W. Line

Elev. 1883

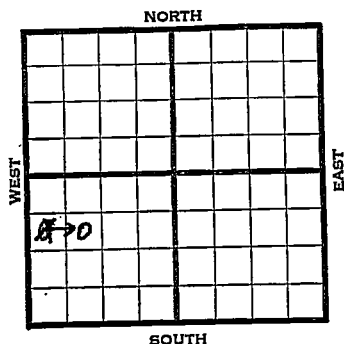

1941

REPORT

8/27

Location

9/4

Surface hole.

9/11

8" - 1070' Drlg. 1440'

9/18

Drlg. 3100'

9/25

Arb. 3395-96' T.D. 5" - 3395'

RUST.

10/1

Arb. 3395'

5" - 3395'

T.D. 3397'

250 acid.

Potential 78 bbls., pump.

33.5 Gravity

COMPLETED

Map No. 71 Sec. 19 Twp. 11 R. 16WWell No. 2 Slimmer
Sinclair Prairie

Company

~~FIRST REPORT~~

Contractor

SECTION PLAT

o			

SE NW SW
990 Ft. from N. Line

Ft. from S. Line

Ft. from E. Line

330 Ft. from W. Line

BEMIS POOL

Location X

Rig up

Drilling and Remarks:

RECORD

Cased _____ in., _____ ft.

Sand _____

Gas _____

Oil _____

Total Depth _____

PRODUCTION

1st 24 hrs. Nat. _____

1st 24 hrs. after shot _____

Gas _____ Cu. Ft.

Dry Hole _____

Abandoned _____

Date

AUG 27 1941 19 S. J. LEWIS Scout

Map No. _____ Sec. 19 Twp. 11 R. 16W

Well No. 2 Slimmer

Sinclair-Prairie Company

CORRECTION Contractor

SE NW SW

990 Ft. from N. Line

Ft. from S. Line

Ft. from E. Line

990 Ft. from W. Line

SECTION PLAT

BEMIS POOL

Location _____

Rig up _____

Drilling and Remarks: \

Had it spotted
wrong

RECORD

Cased _____ in., _____ ft.

Sand _____

Gas _____

Oil _____

Total Depth _____

PRODUCTION

1st 24 hrs. Nat. _____

1st 24 hrs. after shot _____

Gas _____ Cu. Ft.

Dry Hole _____

Abandoned _____

Date

SEP 3 1941 19

S. J. LEWIS

Scout


Map No. K-71 Sec. 19 Twp. 11 R. 16WWell No. 2 SlimmerSinclair Prairie CompanyCOMPLETED Contractor

SECTION PLAT

SE NW SW

990 Ft. from N. Line Ft. from S. Line Ft. from E. Line990 Ft. from W. Line

BEMIS POOL

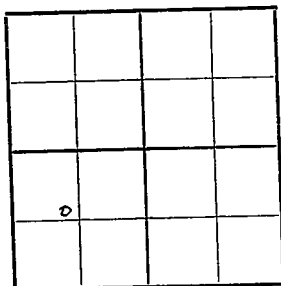

RECORD

Location Cased in., ft.Rig up Sand Drilling and Remarks: Gas Oil Total Depth 3392

PRODUCTION

1st 24 hrs. Nat. 1st 24 hrs. after shot Gas Cu. Ft.Dry Hole Abandoned

Qz 8395
5" @ 3395
200 acid
Pump. 75 P.Y.
335 gr

Date

OCT 1 1941 19 S. J. LEWIS Scout