

ELLIS

KANSAS

19

11S

16W


SECTION \_\_\_\_\_ TOWNSHIP \_\_\_\_\_ RANGE \_\_\_\_\_

WELL NO. #10 Potter

Okmar

COMPANY \_\_\_\_\_

NORTH

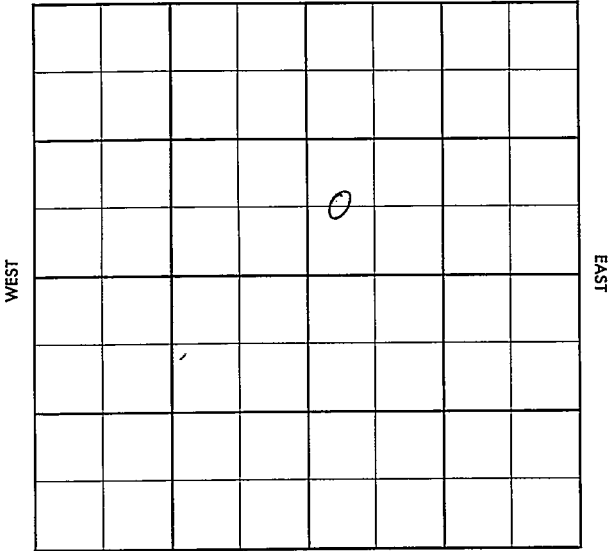

SOUTH

Ellis

KANSAS

SEC. 19	TWP. 11S	R. 16W
------------	-------------	-----------


WELL NO. 10 Potter FARM

COMPANY Okmar

CONTRACTOR rig #3 Sierra Pet.

Bemis Shutts

\_\_\_\_\_ FT. FROM N. LINE  
 \_\_\_\_\_ FT. FROM S. LINE  
 \_\_\_\_\_ FT. FROM E. LINE  
 \_\_\_\_\_ FT. FROM W. LINE

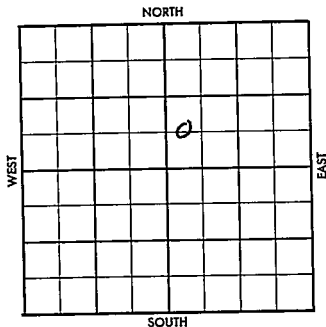

W/2 SW NE

1956	ELEVATION 1882'	REPORT
------	--------------------	--------

6-20 6-13-56  
 8" @1083 w/465  
 Drlg. 2729'

8-8 DD 3412  
 5 1/2" @ 3405  
 CO 3403-05  
 B/ 5 goph, nat. ; no inc; frac;  
 S/ 28 bfph, 90% wtr.  
 P/ 20 bo / 180 bwpd  
 H. 3043'; Tr. 3057'; L. 3089';  
 C. 3362'; S. 3376'; A. 3403';  
 TD 3405'

**COMPLETED**

County Ellis Elev. \_\_\_\_\_  
 Sec. 19 Twp. 11S Rge. 16W  
 Company Okmar  
 Farm Name Pattor No. 10

TOPS	DEPTH	LOG	DATUM
Anh.			
Tr.			
H.			
Tr.			
Dg.			
Bl.			
L.			
K.C.			
B.K.C.			
Ce.			
C.			
M.			
M.			
K.			
Mz.			
Me.			
V.			
S.			
S.			
A.			
R.			
Pe.			
G.			
T.D.			

Loc. in Sec. \_\_\_\_\_  
W/2 SW NE  
 Geol. \_\_\_\_\_  
 Contr rig # 3  
Sierra Pet.  
 Pool \_\_\_\_\_  
Bemis Shutts



Date Comm. 6/13/56 JUN 20 '56  
8<sup>th</sup> 1083 W/465, D 2729

*(Large handwritten scribble)*

JUN 20 1956  
 6/20/56

Co.

Lse.

No.

Sec.

T.

R.

Co.

Loc.

No.

Sec.

T.

R.

County RT. 10

Elev. 1882

Sec. 19

Temp. 115-

Rgs. 16<sup>W</sup>

Company Okmar

Farm Name Potter

No. 10

TOPS	DEPTH	LOG	DATUM	Loc. in Sec.								
Anh.				W/2 SW NE								
TP.												
H.	3043			Geol.								
Tr.	3057											
Dg.				Contr. rig #3								
Bl.												
L.	3089			Sierra Pat.								
K.C.												
B.K.C.				Pool								
Ce.												
C.	3362			Bemis Shuttle								
M.												
M.				COMPLETE								
K.												
Mz.				<table border="1" style="width: 100px; height: 100px;"> <tr><td> </td><td> </td></tr> <tr><td> </td><td> </td></tr> <tr><td> </td><td> </td></tr> <tr><td> </td><td> </td></tr> </table>								
Me.												
V.				<table border="1" style="width: 100px; height: 100px;"> <tr><td> </td><td> </td></tr> <tr><td> </td><td> </td></tr> <tr><td> </td><td> </td></tr> <tr><td> </td><td> </td></tr> </table>								
S.	3376											
S.				COMPLETE								
A.	3403											
R.				COMPLETE								
PE.												
G.				COMPLETE								
TP.	3405											

Date Comm. 6/13/56

AUG 8 '56

RT 1083 W/465, D 2720 JUN 27 '56

5/2 @ 3404 JUL 3 '56 JUL 11 '56 DD 3412

CRNL. 5/2 @ 3405<sup>0</sup> 3403-05

5 Goph rat 11 no inc. frac.

28 BEph 91 to wto JUL 18 '56

Pop JUL 25 '56 AUG 1 '56 AUG 8 '56 P. 20

B0 + 180 BWpd.