


Section 19 Township 11 Range 16W

Well No. #2 Potter-Slimmer

Company Huber et al.
Bemis Pool

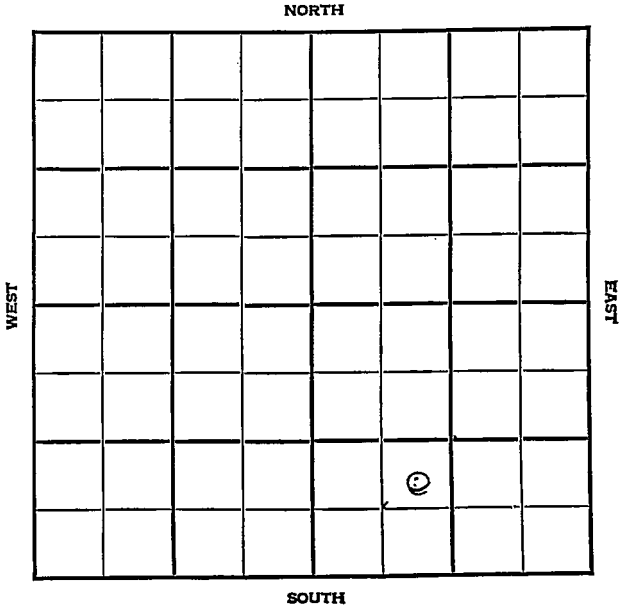

Sec. 19 Twp. 11 R. 16W

Well No. #2 Potter-Slimmer Farm

Huber et al Company


Bemis Pool

 Ft. from N. Line

990' Ft. from S. Line

 Ft. from E. Line

990' Ft. from W. Line

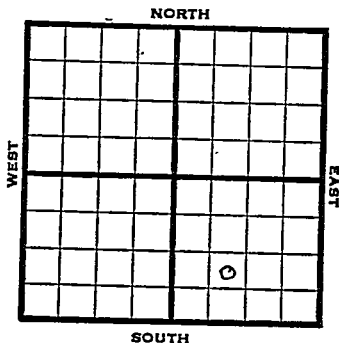

NE SW SE

1948 Eli 1839' REPORT

4/21	RUR	
4/28	Drlg. 1685'	
5/5	Drlg. 3010'	
5/12	Lansing 3047'	
	BKC 3289'	
	Simpson Sd 3341'	
	Arbuckle 3347'	
	TD 3354'	
	5" @ 3349'	
	RUST	
5/19	"	
5/26	"	
6/1	"	
6/9	"	
6/16	TD 3354'	
6/23	Swb 346 bbls oil / 54 W in 16 hrs.	
6/29	"	
7/8	"	"
7/14	"	"
7/19	"	"

OVER

1948

7/28

Arb. 3347'

5" @ 3349'

TD 3354'

Echo Pot 1310 oil \neq 44 % W

36° Gr.

Comp.

COMPLETED

Map No. _____ Sec. 19 Twp. 11 R. 16W

Well No. 2 Potter-Slimmer

Huber etal. Company

FIRST REPORT

Contractor

NE SW SE

SECTION PLAT

_____ Ft. from N. Line

990 Ft. from S. Line

_____ Ft. from E. Line

990 Ft. from W. Line

Ellis County

Location _____

Rig up _____

Drilling and Remarks:

R U R

RECORD

Cased _____ in., _____ ft.

Sand _____

Gas _____

Oil _____

Total Depth _____

PRODUCTION

1st 24 hrs. Nat. _____

1st 24 hrs. after shot _____

Gas _____ Cu. Ft.

Dry Hole _____

Abandoned _____

Date

APR 21 1948

19

S. J. LEWIS

Scout

Ellis County Kansas State

Map No. 71 Sec. 19 Twp. 11 R. 16W

Well No. 2 Potter - Slimmer

Huber et al. Company

COMPLETE

Contractor

NE SW SE

E 11/837

SECTION PLAT

 Ft. from N. Line

990 Ft. from S. Line

 Ft. from E. Line

990 Ft. from W. Line

Bemis Pool

Remarks:

Cr 83347

5" 83349

7" 8354

Ech P 8 1310 oil + 44% W.

36° Sw.

Date
JUL 28 1948

Scout
S. J. LEWIS