


Section 19 Township 17 Range 16W

Well No. 3 Potter - Skimmer "A"

Company Huber et al

Bemis Pool  
NORTH

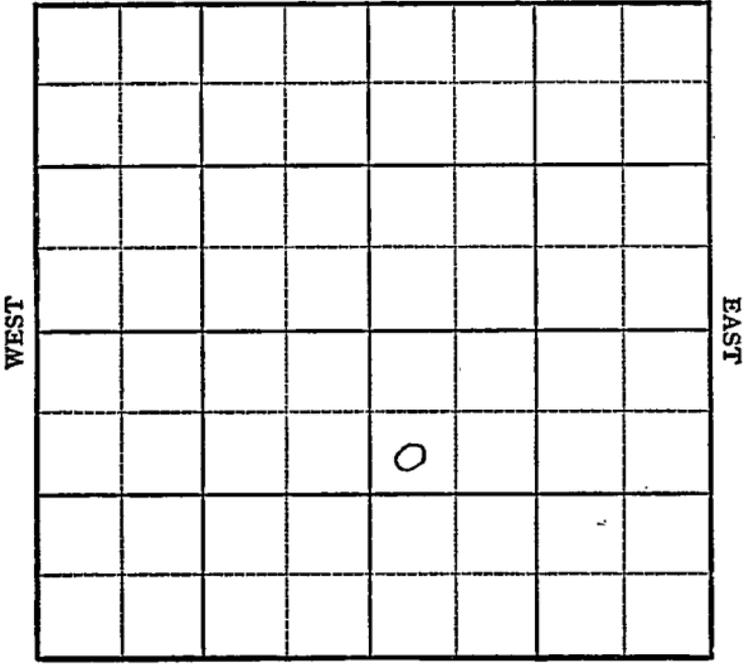

SOUTH



Sec. 19 Twp. 11 R. 16W

Well No. #3 Potter-Skimmer "A" Farm

Huber et al Company  
Bemis Pool


990' Ft. from N. Line

\_\_\_\_\_ Ft. from S. Line

\_\_\_\_\_ Ft. from E. Line

330' Ft. from W. Line

SW NW SE

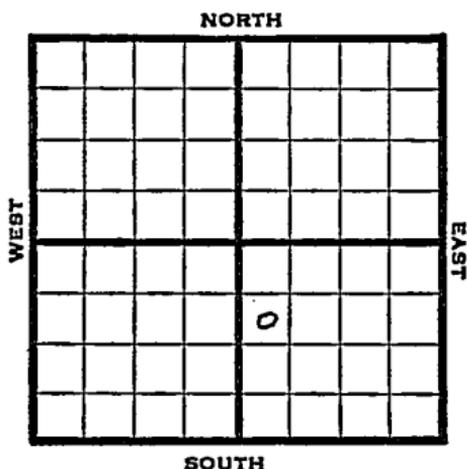

1948 Elev. 1835' REPORT

8/18 Location

8/25 "

9/1 8" @ 1020'  
Lansing 3041'  
Simpson 3310'  
Arbuckle 3330'  
TD 3396'  
Run csg.

9/8 5" @ 33 95'

9/14 5" @ 3395'

9/21 "

9/29 "

10/6 "

10/13 "

10/19 "

10/26 "

11/3 Arb 3330'  
5" @ 3395'  
Perf  
5000 acid  
Pump 317 oil & 22% W Pot.  
Gr. 36°  
TD 3396'

COMPLETED

Ellis County Kansas State

Map No. \_\_\_\_\_ Sec. 19 Twp. 11 R. 16W

Well No. 3 Potter - Skimmer "A"

Huber et al. Company

**FIRST REPORT**

Contractor \_\_\_\_\_

SW NW SE

**SECTION PLAT**


990 Ft. from N. Line

\_\_\_\_\_ Ft. from S. Line

\_\_\_\_\_ Ft. from E. Line

330 Ft. from W. Line

**Bemis Pool**

Remarks:

Location



Date  
AUG 18 1948

Scout S. J. LEWIS

Map No. 71 Sec. 19 Twp. 11 R. 16W

Well No. 3 Potter - Skinner "A"

Huber etal. Company

**COMPLETE**

Contractor

SW NW SE

*E. 11835*  
**SECTION PLAT**

990 Ft. from N. Line  
         Ft. from S. Line  
         Ft. from E. Line  
330 Ft. from W. Line


Ellis County

Location \_\_\_\_\_

Rig up \_\_\_\_\_

Drilling and Remarks:

*Art 3380*

*5" @ 3395*

*Perf.  
Stoacid*

*Prod @ 170 oil + 22% W*

*Art 360-34*

**RECORD**

Cased \_\_\_\_\_ in., \_\_\_\_\_ ft.

Sand \_\_\_\_\_

Gas \_\_\_\_\_

Oil \_\_\_\_\_

Total Depth 3396

**PRODUCTION**

1st 24 hrs. Nat. \_\_\_\_\_

1st 24 hrs. after shot \_\_\_\_\_

Gas \_\_\_\_\_ Cu. Ft.

Dry Hole \_\_\_\_\_

Abandoned \_\_\_\_\_

Date

NOV 3 1948 19

S. J. LEWIS Scout