



KANSAS

Ellis County ✓

Sec. 19 Twp. 11 R. 18-W

Well No. 1 Miller Farm  
Skelly Company


Richards Pool

\_\_\_\_\_ Ft. from N. Line

330 Ft. from S. Line

330 Ft. from E. Line

\_\_\_\_\_ Ft. from W. Line

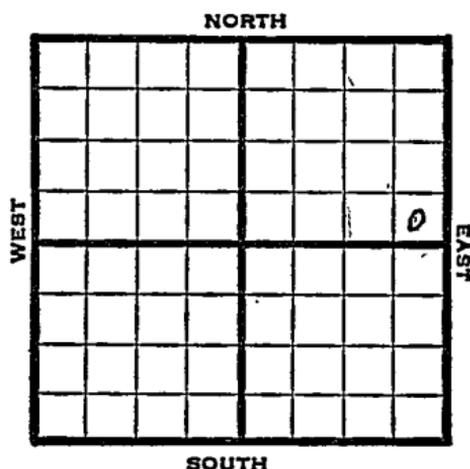

SE NE

1947	Elev. REPORT 2074'
7/30	Loc.
8/6	"
8/13	13" @ 157 Drlg. 575'
8/20	8" @ 1392' Drlg. 3050'
8/27	Lans. 3318' Cong. 3585' Simp. 3614' Arbuckle 3641' Total Depth 3670'
	<b>ABANDONED</b>

Map No. \_\_\_\_\_ Sec. 19 Twp. 11 R. 18W

Well No. 1 Miller

Skelly \_\_\_\_\_ Company

**FIRST REPORT**

\_\_\_\_\_  
Contractor

SE NE


**SECTION PLAT**

\_\_\_\_\_ Ft. from N. Line

330 Ft. from S. Line

330 Ft. from E. Line

\_\_\_\_\_ Ft. from W. Line

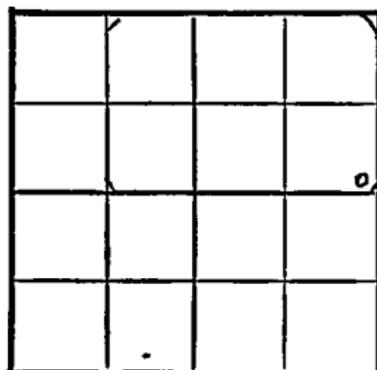

Ellis County

Location X

Rig up \_\_\_\_\_

Drilling and Remarks:

**RECORD**

Cased \_\_\_\_\_ in., \_\_\_\_\_ ft.

Sand \_\_\_\_\_

Gas \_\_\_\_\_

Oil \_\_\_\_\_

Total Depth \_\_\_\_\_

**PRODUCTION**

1st 24 hrs. Nat. \_\_\_\_\_

1st 24 hrs. after shot \_\_\_\_\_

Gas \_\_\_\_\_ Cu. Ft.

Dry Hole \_\_\_\_\_

Abandoned \_\_\_\_\_

Date

JUL 30 1947 19

S. J. LEWIS Scout

Map No. 71 Sec. 19 Twp. 11 R. 18W

Well No. 1 Miller

Skelly Company

**ABANDONED** Contractor

SE NE

*E12074*

SECTION PLAT

         Ft. from N. Line

330 Ft. from S. Line

330 Ft. from E. Line

         Ft. from W. Line


Ellis County

Location                                 

Rig up                                 

Drilling and Remarks:

*Lewis 3318*  
*Cong 3355*  
*Comp 3614*  
*EE 3641*

RECORD

Cased          in.,          ft.

Sand                                 

Gas                                 

Oil                                 

Total Depth 3670

PRODUCTION

1st 24 hrs. Nat.                                 

1st 24 hrs. after shot                                 

Gas                                  Cu. Ft.

Dry Hole                                 

Abandoned                                 

Date

AUG 27 1947 19

S. J. LEWIS Scout