


Section 19 Township 11 Range 19 W

Well No. # 1 Rathburn "B"

Company Virginia Drlg.

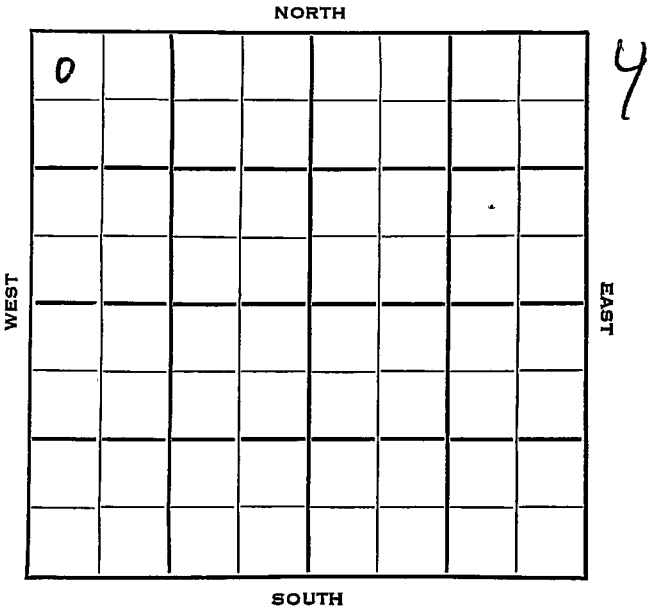

Ellis

KANSAS

SEC.	19	TWP.	11	R.	19W
------	----	------	----	----	-----

WELL NO. #1 Rathburn "B" FARM

COMPANY Virginia Drlg.


CONTRACTOR Virginia Drlg.
Wildcat

330 Ft. from N. Line

Ft. from S. Line

Ft. from E. Line

330 Ft. from W. Line

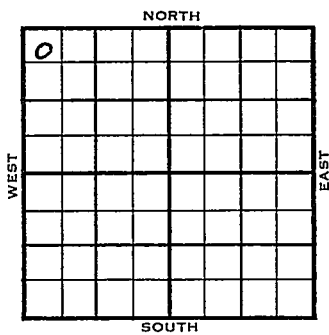

NW NW NW
CSO F/O
Skelly - DHM

1953	ELEVATION 1986'	REPORT
------	--------------------	--------

10/14 Spud 10-6-53
8" @ 206'
Anhy 1350'
Drlg 2995'

1021 Spud 10-6-53
D&A
TD 3618
8" @ 206'
Anhy 1350, Top 3015, Heeb 3239,
Dodge 3258, ans 3280; Marm. 3550,
Cong 3586, Simp. 3592, Arb. 3596
TD 3618
D&A

ABANDONED

County Ellis State Kansas

Sec. 19 (Blk.) 11 (Sur.) 19W Map No.

Operator Virginia Drlg.

Well No. 1 Farm Rathburn "B"

Elev. 1986 Location NW NW NW

0					
FIRST REPORT					

330 Ft. From N Line NW

330 Ft. From W Line Quarter

Ist. Report OCT 14 1953

Completion

Remarks CSO farmout
Skelly - THM

Virginia Drlg. - Contr.

Spudding Date 10-6-53

Drlg. Data Wildcat

8" @ 206 Anhy 1350 drlg. 2995

County Ellis State Kansas

Sec. 19 (Blk. 11 (Sur. 19W Map No. (Twp.) (Rge.))

Operator Virginia Drlg.

Well No. 1 Farm Rathburn "B"

Elev. 1986 Location NW NW NW

0					

330 Ft. From N Line NW

330 Ft. From W Line Quarter

1st. Report

OCT 21 1952

Completion

Remarks Wildcat

Virginia Drlg. - Contr.

Spudding Date 10-6-53

Drlg. Data D & A TD 3618

8" @206 Anhy 1350 Top. 3015

Heeb. 3239 Dodge 3258 Lans. 3280

Marm. 3550 Cong. 3586 Simp. 3592

Arb. 3596 TD 3618

D & A