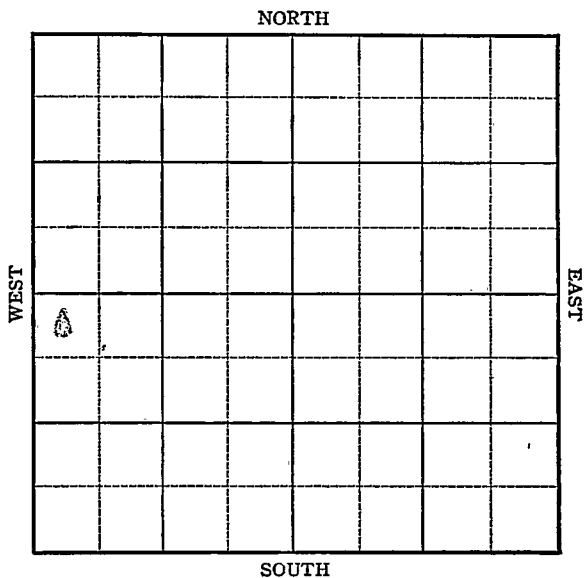


Ellis

KANONGSection 19 Township 11 Range 17-WWell No. #1 PeaveyCompany Champlin Ref.

KANSAS

Ellis County

Sec. 19 Twp. 11 R. 17W

Well No. #1 Peavey Farm

Champlin Ref. Company

Bemis


330 Ft. from N. Line

 Ft. from S. Line

 Ft. from E. Line

330 Ft. from W. Line

NW SW

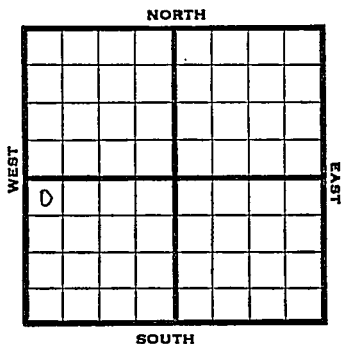

1946

Elev. 1869' REPORT

1/9

Location

1/17

13" - 120' Drlg. 2275'

1/24

Drlg. 3360'

1/31

T.D. 3398' 5" - 3387' RUST.

2/7

Arb. 3385' T.D. 3399'
1000 acid. Swab 39 oil in 12 hours.

2/14

" " "

2/21

" " "

2/27

Arb. 3385
5" @ 3387
TD 3399'
1000 acid.
Pump 50 Pot.
Grav. 34.6


COMPLETED

KANSAS

Kansas Pool Name BemisMap No. 71 Sec. 19 Twp. 11 R. 17WWell No. 1 PeaveyChamplin Ref. CompanyFIRST REPORT Contractor

NW SW

SECTION FLAT

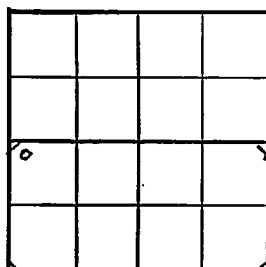330 Ft. from N. Line Ft. from S. Line Ft. from E. Line330 Ft. from W. Line

Ellis County

Location XRig up

Drilling and Remarks:

RECORD

Cased in, ft.Sand Gas Oil Total Depth

PRODUCTION

1st 24 hrs. Nat. 1st 24 hrs. after shot Gas Cu. Ft.Dry Hole Abandoned

Date

JAN 9 1946 19S. J. LEWIS

Scout

Kansas Pool Name Bemis
 Map No. 7/ Sec. 19 Twp. 11 R. 17W
 Well No. 1 Peavey

Champlin Ref.

Company

COMPLETED

Contractor

NW SW

21, 1939
 SECTION PLAT
330 Ft. from N. Line Ft. from S. Line Ft. from E. Line
330 Ft. from W. Line

Δ			

Ellis County

Location

Rig up

Drilling and Remarks:

As 33855" @ 33871000 acidPump 50 Bx346

RECORD

Cased in., ft.Sand Gas Oil Total Depth 3387

PRODUCTION

1st 24 hrs. Nat. 1st 24 hrs. after shot Gas Cu. Ft.Dry Hole Abandoned

Date

FEB 27 1946

19

S. J. LEWIS

Scout