

Section 19 Township 11 Range 17W

Well No. #1 Peavy "A"


Company Lario Oil & Gas

Bemis Pool

NORTH

WEST

EAST

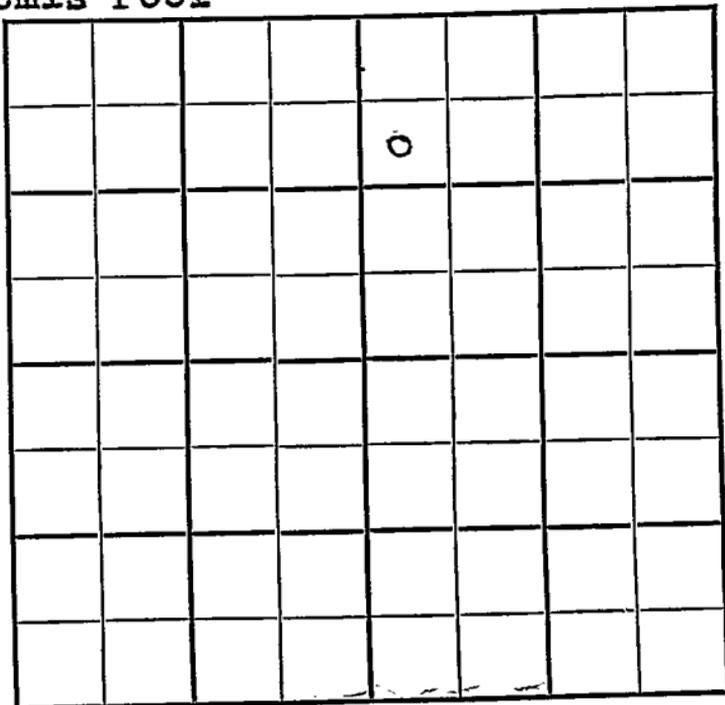

SOUTH

KANSAS -

Ellis

Sec. 19

Twp. 11

R. 17<sup>W</sup>

Well No. 1 Peavy "A" Farm

Lario Oil & Gas Company


Bemis Pool

990<sup>n</sup> Ft. from N. Line

Ft. from S. Line

Ft. from E. Line

330<sup>t</sup> Ft. from W. Line

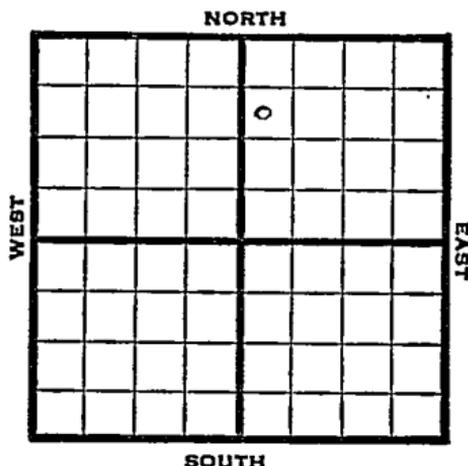

SW NW NE

Elev. 1948<sup>t</sup> REPORT

1947

10/29 Loc.

11/5 Drlg. 925<sup>t</sup>

11/12 8" @ 1205<sup>t</sup>  
Drlg. 1650<sup>t</sup>

11/25 Lansing 3192  
Arbuckle 3551  
TD 3576

**ABANDONED**

Bemis Pool

Form 26 200 Bks. 10-46 Petrol  
Kansas

Map No. \_\_\_\_\_ Sec. 19 Twp. 11 R. 17W

Well No. 1 Peavy "A"

Lario Oil & Gas Company

**FIRST REPORT** Contractor

SW NW NE


**SECTION PLAT**

990 Ft. from N. Line

\_\_\_\_\_ Ft. from S. Line

\_\_\_\_\_ Ft. from E. Line

330 Ft. from W. Line

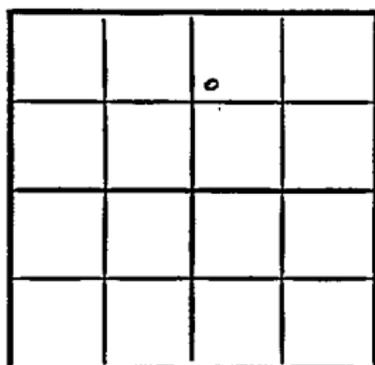

Ellis County

Location X

Rig up \_\_\_\_\_

Drilling and Remarks:

**RECORD**

Cased \_\_\_\_\_ in., \_\_\_\_\_ ft.

Sand \_\_\_\_\_

Gas \_\_\_\_\_

Oil \_\_\_\_\_

Total Depth \_\_\_\_\_

**PRODUCTION**

1st 24 hrs. Nat. \_\_\_\_\_

1st 24 hrs. after shot \_\_\_\_\_

Gas \_\_\_\_\_ Cu. Ft.

Dry Hole \_\_\_\_\_

Abandoned \_\_\_\_\_

Date

OCT 29 1947

19

S. J. LEWIS

Scout

