


Section 19 Township 11 Range 17W
Well No. #2 Peavey "A"
Company Murfin Drlg. Co.

NORTH

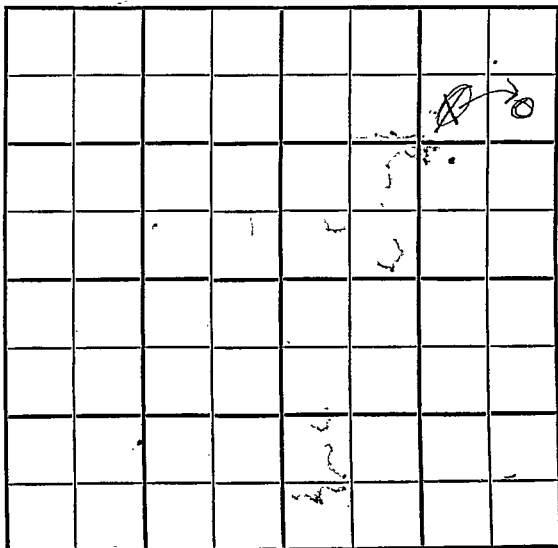

SOUTH

County Ellis Elev. _____
 Sec. 19 Twp. 11 Rge. 17W
 Company Murfin Drlg. Co.
 Farm Name Peavey "A" No. 2

TOPS	DEPTH	LOG	DATUM
Anh.			
Tr.			
H.			
Tr.			
Dg.			
Bl.			
L.			
K.C.			
B.K.C.			
Ce.			
C.			
M.			
M.			
K.			
Mz.			
Mo.			
V.			
S.			
S.			
A.			
R.			
Pe.			
G.			
T.D.			

Loc. in Sec. _____

SW NE NE

Geol. _____

Contr. _____

Co. Tools _____

Pool _____

Burnett

NOV 21 1932

FIRST REPORT

Date Comm. _____

Location _____

Co.

Lse.

No.

Sec.

T.

R.

CORRECTION

FORM 513 SUNRAY

County Ellis Elev. 2101 DF
 Sec. 19 Twp. 11 Rge. 17W
 Company Murfin Dr Ig. Co.
 Farm Name Peavey "A" No. 2

TOPS	DEPTH	LOG	DATUM	Loc in Sec.
Anb.				SE NE NE
TP.				800' FNL
H.				400' FEL of NE
Tr.				
Dg.				
Bl.				
L.	3315			Geol.
K.C.				Contr.
B.K.C.				Co. Tools
Ce.				Pool
C.				Burnett
M.				
M.				
K.				
Mz.				
Ma.				
V.				
S.				
S.				
A.	3595			FEB 13 '57
R.				
PE				COMPLETE
G.				
T.D.	3598			

Date Comm.

Location NOV 28 '56 X Loc. DEC 5 '56 V

DEC 12 '56 12-10-56 8 5/8 380 / 225

DEC 19 '56 3295 DEC 26 '56 DST 3390

-3406 30" rec 3' Md BHP

350 DST 3411-18 1 hr 240'

oil + 180' wty oil + 75' wty

BHP 1080 DST 3470-90 1 hr

500' oil E MCO BHP 1000

5 1/2 c 3596 woot JAN 2 '57 V JAN 2 '57

CO 3598 \$ rate 65

Boph 1500/-0. B. nat.

Pop JAN 10 1957 JAN 23 57 JAN 30 57 FEB 6 57

FEB 13 57 est 150 Bopd no/wtr.

9-11-7

situated