


Section 19 Township 11 Range 20W

Well No. #1 Vance

Company Imperial Pet.

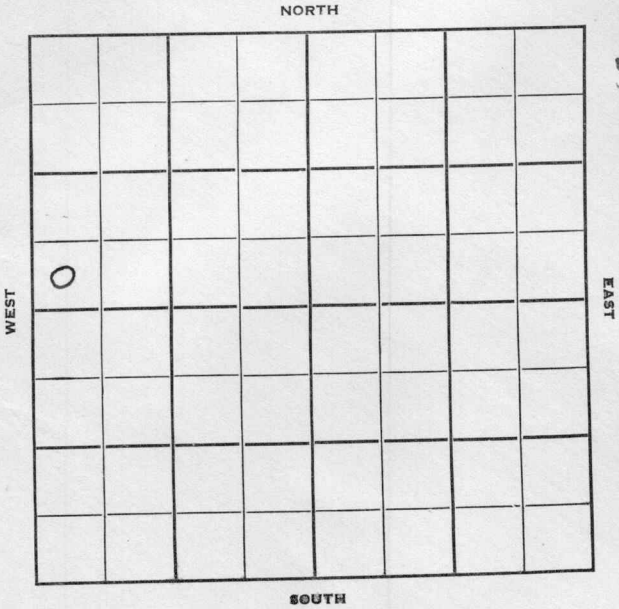

Sec. 19 Twp. 11 R. 20 W

Well No. # 1 Vance Farm

Imperial Pet. Company

D & M Contractor

Wildcat


Ft. from N. Line

330 Ft. from S. Line

Ft. from E. Line

330 Ft. from W. Line

SW SW NW

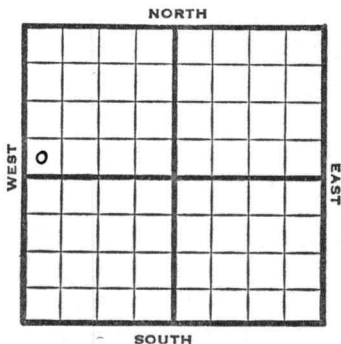

1951

Elev. 2232' REPORT

11/14
1952
2/6

Location

Spud 11-21-51
Oil Well T 3844
8" @ 257
Top. 3268 Heeb. 3484
Lans. 3521
DST 3522-59 open $\frac{1}{2}$ hr. Rec. 35' mud
DST 3568-82 open $\frac{1}{2}$ hr. Rec. 10' oil
110' OCM 30' mud
DST 3088-3612 open 45 min. rec. 480'
MCO
DST 3670-3825 open 1 hr. rec. 180'
oil 160' mud & oil
Cong. 3779
DST 3797-3806 open 1 hr. rec. 5' mud
Arb. 3831-35 5" @ 3832 TD 3844
B/ 10 GOPH 500 A wtr. PB 3740
24/ 3712-16 B/ 1 BOPH 500 A
S/ 20 BOPH 16/ 3708-12 16/ 3716-20
4000 A S/ 20 BOPH PB 3628
24/ 3610-14 Wtr. 18/3598-3604
S/ 2 $\frac{1}{2}$ BWPB 16/3596-3602 B/ $\frac{1}{2}$ bwph
& SSO 1000 A S/ 13 BWPB sq. off
PB 3594 34/ 3587-94 B/ 20 GOPH
500 A S/ 9 BWPB 1 BOPH sq/ off
CO to 3740 S/ 5 BOPH Comp. 316 BOPD
7% wtr.

COMPLETED

County Ellis State Kansas

Sec. 19 (Blk. 11 (Sur. Rge.) 20W Map No. (Twp.)

Operator Imperial Pet.

Well No. 1 Farm Vance

Elev. 2232 Location SW SW NW

| | | | | |
|--|--|--|--|--|
| | | | | |
| | | | | |
| | | | | |
| | | | | |
| | | | | |
| | | | | |
| | | | | |
| | | | | |
| | | | | |
| | | | | |

330 Ft. From S Line NW

330 Ft. From W Line Quarter

1st. Report

Completion FEB 6 1952

Remarks Wildcat

Spudding Date 11-21-51

Drlg. Data Oil well TD 3844

8" @ 257 Top. 3268 Heeb. 3484

Lans. 3521 DST 3522-59 open 1/2 hr.

Rec. 35' mud DST 3568-82 open 1/2 hr.

Rec. 10' oil 110' ocm 30' mud

DST 3088-3612 open 45 min. Rec. 480' mco

DST 3670-3825 open 1 hr. Rec. 180' oil

160' mud & oil Cong. 3779 DST 3797-3806

open 1 hr. Rec. 5' mud Arb. 3831-35

5" @ 3832 TD 3844 B/ 10 boph 500 A

water PB 3740 24/ 3712-16 B/ 1 boph

500 A S/ 20 boph 16/ 3708-12

16/ 3716-20 4000 A S/ 20 boph

PB 3628 24/ 3610-14 water 18/ 3598-360

3604

Drig. Data

S/ $2\frac{1}{2}$ bwph 16/ 3596-3602 B/ $\frac{1}{2}$ bwph & SSO

1000 A S/ 13 bwph sq. off PB 3594

34/ 3587-94 B/ 20 goph 500 A

S/ 9 bwph 1 boph sq. off CO to 3740

S/ 5 boph Comp. 316 bopd 7% water

FEB 13 1952

| | |
|-------|----------------|
| | Misc. |
| | Pierce Map |
| | France Map |
| | Tracings |
| | Land Wall Map |
| | Land Small Map |
| | Scout Cards |

[Handwritten signature]