

KANSAS

Ellis

FORM 51 IOM 12-46 PETROL

Section 19 Township 11 Range 17-WWell No. 2 Peavy "D"Company Champlin Ref.

Bemis Pool

NORTH

WEST

EAST

o							
x							

SOUTH

KANSAS Ellis

Sec. 19 Twp. 11 R. 17W

Well No. #2 Peavy "D" Farm

Champlin Ref. Company

Bemis

Ft. from N. Line


990

330 Ft. from S. Line

Ft. from E. Line

330 Ft. from W. Line

SW/4 NW - SW SW,

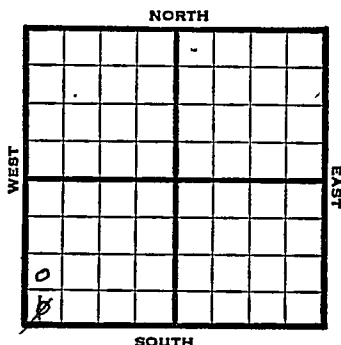

1947

Elev. 1928' REPORT

9/17 Surface hole.

9/24 10" @ 160' -
Anhydrite 1165'
Drlg. 2690'

10/1 Topeka 2900'
Lansing 3174'
Conglomerate 3425'
Arbuckle 3429'
TD 3468'
5" @ 3468'
RUST

10/8 24 shots 3429-37- swb 2 bbls
oil PH, 24 hrs - 1000 acid

10/15 1500 acid no help
24 shots. 3442-47' SD.

10/22 Swb 60 bbls oil 24 hrs.

10/29 "

11/5 Pump 15 bbls oil aday

11/12 "

OVER

1947

11/19

Lans. 31748

Arb. 3439'

5" @ 3468'

Perf. Arb. - 1500 acid.

Pump 50 oil Pot / 3% W

36.0 Gr.

TD 3468'

COMPLETED

Map No. 71 Sec. 19 Twp. 11 R. 17W

Well No. 2 Peavy "D"

Champlin Ref. Company

FIRST REPORT

Contractor

SW/C

SECTION PLAT


 Ft. from N. Line

330 Ft. from S. Line

 Ft. from E. Line

330 Ft. from W. Line

Ellis County

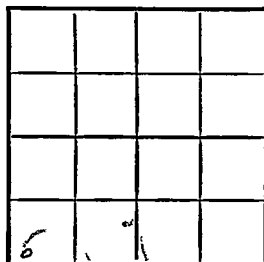

Location

Rig up

Drilling and Remarks:

surface hole

RECORD

Cased in. ft.

Sand

Gas

Oil

Total Depth

PRODUCTION

1st 24 hrs. Nat.

1st 24 hrs. after shot

Gas Cu. Ft.

Dry Hole

Abandoned

Date

SEP 17 1947 19

S. J. LEWIS Scout


Wm

Misc. Small Maps	<i>[initials]</i>
Cards	<i>Luth</i>
Tracing	
France Map	<i>[initials]</i>
Scarborough Map	<i>[initials]</i>
Pierce Map	
Geological Dept.	
Pierce Plat Book	

Map No. 71 Sec. 19 Twp. 11 R. 17WWell No. 2 Peavy "D"Champlin Ref. CompanyCORRECTION Contractor

NW SW SE

SECTION PLAT

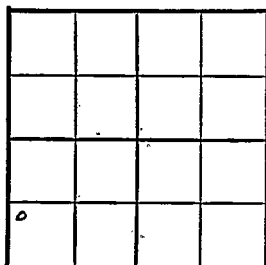 Ft. from N. Line990 Ft. from S. Line Ft. from E. Line330 Ft. from W. LineEllis CountyLocation Rig up

Drilling and Remarks:

Reported

SW/C

RECORD

Cased in, ft.Sand Gas Oil Total Depth

PRODUCTION

1st 24 hrs. Nat. 1st 24 hrs. after shot Gas Cu. Ft.Dry Hole Abandoned

Date

SEP 24 1947 19S. J. LEWIS Scout

2mm

Misc. Small Maps	<i>JS</i>
Cards	<i>JS</i>
Tracing	<i>JS</i>
France Map	<i>JS</i>
Scarborough Map	<i>JS</i>
Pierce Map	<i>JS</i>
Geological Dept.	
Pierce Plot Book	

Map No. 71 Sec. 19 Twp. 11 R. 17W

Well No. 2 Peavy "D"

Champlin Ref. Company

COMPLETE

Contractor

NW SW SW

E 11928
SECTION PLAT

 Ft. from N. Line

990 Ft. from S. Line

 Ft. from E. Line

330 Ft. from W. Line

Ellis County

Location

Rig up

Drilling and Remarks:

Lane 3174
CR 8429
5" @ 8468
Perf. Cr.
1000 acid
Pump 50 oil Per
43% W. 86%

RECORD

Cased in., ft.

Sand

Gas

Oil

Total Depth 8468

PRODUCTION

1st 24 hrs. Nat.

1st 24 hrs. after shot

Gas Cu. Ft.

Dry Hole

Abandoned

Date

NOV 19 1947 19 S. J. LEWIS Scout

Misc. Small Maps

Cards

Tracing

France Map

Scarborough Map

Pierce Map

Geological Dept.

Pierce Plat Book