

TYPE

AFFIDAVIT OF COMPLETION FORM

ACO-1 WELL HISTORY

SIDE ONE

State Geological Survey

Compt. _____

(Rules 82-3-130 and 82-3-107)

WICHITA BRANCH

DOCKET NO. NP _____

This form shall be filed with the Kansas Corporation Commission, 200 Colorado Derby Building, Wichita, Kansas 67202, within ninety (90) days after the completion of a well, regardless of how the well was completed.

FOR INFORMATION REGARDING THE NUMBER OF COPIES TO BE FILED AND APPLICATIONS REQUIRING COPIES OF ACO-1 FORMS SEE PAGE TWO (2), SIDE TWO (2) OF THIS FORM.

(F) ☒ Letter requesting confidentiality attached.

(C) ☒ Attach ONE COPY of EACH wireline log run (i.e. electrical log, sonic log, gamma ray neutron log etc.)***Check here if NO logs were run _____.

PLEASE FILL IN ALL INFORMATION. IF NOT AVAILABLE, INDICATE. IF INFORMATION LATER BECOMES AVAILABLE, SUBMIT BY LETTER.

LICENSE # 8954 EXPIRATION DATE August 1984

OPERATOR Seahawk Oil International, Inc. API NO. 15-051-23,686

ADDRESS 660 Newport Center Drive, Suite 750 COUNTY Ellis
Newport Beach, CA 92660 FIELD Cockran, W.

** CONTACT PERSON Candace Salway PROD. FORMATION Lansing/KC
 PHONE (714) 644-4444 Indicate if new pay.

PURCHASER Koch Oil Company LEASE Alison

ADDRESS Box 2256 WELL NO. 6
Wichita, Kansas 67201 WELL LOCATION NW SE NE

DRILLING KANDRILCO, Inc. Lic. # 5889 1650 Ft. from N Line and
 CONTRACTOR 555 North Woodlawn 990 Ft. from E Line of ~~XXX~~
 ADDRESS Bldg. 1 - Suite 207 the NE (Qtr.) SEC 13 TWP 11S RGE 19 W
Wichita, Kansas 67208

PLUGGING _____

CONTRACTOR _____

ADDRESS _____

TOTAL DEPTH 3520 PBD 3429'

SPUD DATE 10/25/83 DATE COMPLETED 11/02/83

ELEV: GR 1906 DF 1911 KB 1914

DRILLED WITH ~~(CABLE)~~ (ROTARY) ~~TOOLS.~~

DOCKET NO. OF DISPOSAL OR REPRESSURING WELL BEING USED TO DISPOSE OF WATER FROM THIS LEASE _____


Amount of surface pipe set and cemented 1265 DV Tool Used? No

TYPE OF COMPLETION THIS AFFIDAVIT APPLIES TO: (Circle ONE) - (Oil), Shut-in Gas, Gas, Dry, Disposal, Injection, Temporarily Abandoned. If OWWO, indicate type of re-completion _____. Other completion _____. NGPA filing _____.

WELL PLAT

(Office Use Only)

KCC _____
 KGS ☒
 SWD/REP _____
 PLG. _____
 NGPA _____

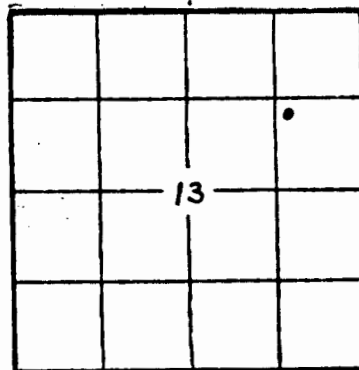

ALL REQUIREMENTS OF THE STATUTES, RULES AND REGULATIONS PROMULGATED TO REGULATE THE OIL AND GAS INDUSTRY HAVE BEEN FULLY COMPLIED WITH.

A F F I D A V I T

Candace Salway, Geologist, being of lawful age, hereby certifies

RECEIVED

THE CORPORATION COMMISSION Affiant, and I am familiar with the contents of the foregoing Affidavit. The statements and allegations contained therein are true and correct.