

19-11-19W PL

TYPE AFFIDAVIT OF COMPLETION FORM ACO-1 WELL HISTORY

SIDE ONE

Two (2) copies of this form shall be filed with the Kansas Corporation Commission, 200 Colorado Derby Building, Wichita, Kansas 67202, within thirty (30) days after the completion of a well, regardless of how the well was completed.

Attach separate letter of request if the information is to be held confidential. If confidential, only file one copy. Information on Side One will be of public record and Side Two will then be held confidential.

Applications must be made on dual completion, commingling, salt water disposal, injection and temporarily abandoned wells.

Attach one copy only wireline logs (i.e. electrical log, sonic log, gamma ray neutron log, etc.). (Rules 82-2-105 & 82-2-125) KCC# (316) 263-3238.

LICENSE # 6033 EXPIRATION DATE _____

OPERATOR Murfin Drilling Company API NO. 15-051-23,073

ADDRESS 617 Union Center Bldg. COUNTY Ellis

Wichita, KS 67202 FIELD Wildcat

** CONTACT PERSON Ramona Gunn PROD. FORMATION _____
PHONE 316-267-3241

PURCHASER _____ LEASE Hosley

ADDRESS _____ WELL NO. 1-19

DRILLING CONTRACTOR Murfin Drilling Company WELL LOCATION 500' fsl 1980' fEL

ADDRESS 617 Union Center Bldg. 500 Ft. from South Line and
Wichita, KS 67202 1980 Ft. from East Line of
the (Qtr.) SEC 19 TWP 11SRGE 19W.

PLUGGING CONTRACTOR Murfin Drilling Company

ADDRESS 617 Union Center Bldg.

Wichita, KS 67202

TOTAL DEPTH 3770' PBTD _____

SPUD DATE 8-10-82 DATE COMPLETED 8-19-82

ELEV: GR 2110' DF _____ KB 2115'

DRILLED WITH ~~(CABLE)~~ (ROTARY) ~~(AIR)~~ TOOLS.

DOCKET NO. OF DISPOSAL OR REPRESSURING WELL BEING USED TO DISPOSE OF WATER FROM THIS LEASE _____

Amount of surface pipe set and cemented 218' DV Tool Used? _____

THIS AFFIDAVIT APPLIES TO: (Circle ONE) - Oil, Gas, Shut-in Gas, Dry, Disposal, Injection, Temporarily Abandoned, OWWO. Other _____

ALL REQUIREMENTS OF THE STATUTES, RULES AND REGULATIONS PROMULGATED TO REGULATE THE OIL AND GAS INDUSTRY HAVE BEEN FULLY COMPLIED WITH.


A F F I D A V I T

David L. Murfin, being of lawful age, hereby certifies that:

I am the Affiant, and I am familiar with the contents of the foregoing Affidavit. The statements and allegations contained therein are true and correct.

David L. Murfin
(Name)

State Geological Survey
WICHITA BRANCH

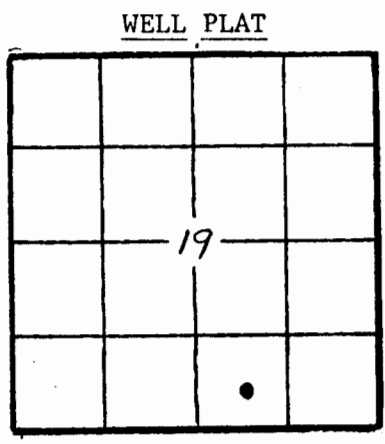

(Office Use Only)
KCC _____
KGS
SWD/REP _____
PLG. _____

P1

SIDE TWO

ACO-1 WELL HISTORY

OPERATOR Murfin Drilling Co. LEASE Hosley #1-19 SEC. 19 TWP, 11S RGE. 19W

FILL IN WELL LOG AS REQUIRED:

Show all important zones of porosity and contents thereof; cored intervals, and all drill-stem tests, including depth interval tested, cushion used, time tool open, flowing and shut-in pressures, and recoveries.			SHOW GEOLOGICAL MARKERS LOGS RUN, OR OTHER DESCRIPTIVE INFORMATION.	
FORMATION DESCRIPTION, CONTENTS, ETC.	TOP	BOTTOM	NAME	DEPTH
Rock		60'	<u>LOG TOPS</u>	
Shale		218'		
Shale & Sand		1474'	Anhydrite	1473' (+642)
Anhydrite		1517'	B/Anhydrite	1512' (+603)
Shale		2810'	Topeka	3123' (-1008)
Shale & Lime		3320'	Heebner	3343' (-1228)
Lime		3430'	Toronto	3353' (-1238)
Lime & Shale		3585'	Lansing	3382' (-1267)
Lime		3630'	Arbuckle	3688' (-1573)
Lime & Shale		3670'		
Lime & Arb.		3697'		
Lime		3770'		
DST #1: 3408-30'/45-45-45-45. Rec. 10' M. SIP: 32-32#. FP: 32-32/32-32#.				
DST #2: 3430-61'/45-45-60-60. Rec. 97' MW. FP: 33-44/44-65#. SIP: 1020-910#. HP: 1826-1804#.				
DST #3: 3528-85'/45-45-45-45. Rec. 3.1' G + 5.1' O + 3.3' W + 55.45' M. HP: 1880-1859#. SIP: 360-175#. FP: 55-55/65-65.				
DST #4: 3598-3649'/45-45-45-45. Rec 10' M, few 0 spks. HP: 1978-1950#. SI: 98-55#. FP: 44-44/44-44#.				
DST #4: 3691-3697'. Rec 20' O + 62' OCM. HP: 1956-1935#. FP: 33-33/44-44#. SIP: 910-833#.				
DST #6: 3697-3707'/45-45-45-45. Rec 15' MW w/ slight show of) + 868' SW. HP: 1978-1957#. SIP: 1151-1151#. FP: 55/240-260/436#.				

Report of all strings set — surface, intermediate, production, etc. **CASING RECORD** (New) or (Used)

Purpose of string	Size hole drilled	Size casing set (in O.D.)	Weight lbs/ft.	Setting depth	Type cement	Sacks	Type and percent additives

LINER RECORD

PERFORATION RECORD

Top, ft.	Bottom, ft.	Sacks cement	Shots per ft.	Size & type	Depth interval

TUBING RECORD

Size	Setting depth	Pecker set at