

KANSAS WELL LOG BUREAU --- KANSAS GEOLOGICAL SOCIETY
 508 EAST MURDOCK - WICHITA, KANSAS

COMPANY **BROOKS PIERCE DRILLING COMPANY**


SEC. 23 T. 11 R. 19W

FARM **Vine** NO. **1**


LOC. **NW NW SW**

TOTAL DEPTH **3543**
 COMM. **11-15-50** COMP. **11-27-50**
 SHOT OR TREATED
 CONTRACTOR
 ISSUED **6-9-51**

COUNTY **Ellis**

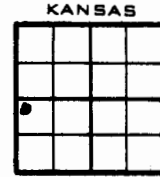

8 5/8" CASING 194' cem w/150 sx.

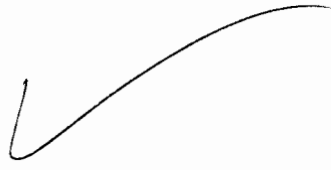

2015RB (2nd.)

ELEVATION **2013 DF**

PRODUCTION **Draw down Potential**
906 bbls oil

FIGURES INDICATE BOTTOM OF FORMATIONS

surface clay	45
shale	90
shale & shells	760
sand	890
shale , shells	1300
sand, shale	1320
anhydrite	1350
shale	1360
shale, shells	1555
shale	1885
shale, shells	2020
lime	2120
lime, shale	2320
lime	2380
shale, lime	2690
shale	2865
lime, shale	2905
lime	3160
lime, shale	3184
shale	3204
lime	3205
conglomerate	3535
lime	3543
Total Depth	

Set Casing.

Tops:
 Lansing-Kansas
 City 3225
 Conglomerate 3480
 Simpson 3507
 Arbuckle 3533