


Section 27 Township 11 Range 2-W

Well No. #1 C.A. Quinn

Company H.B. Peatling

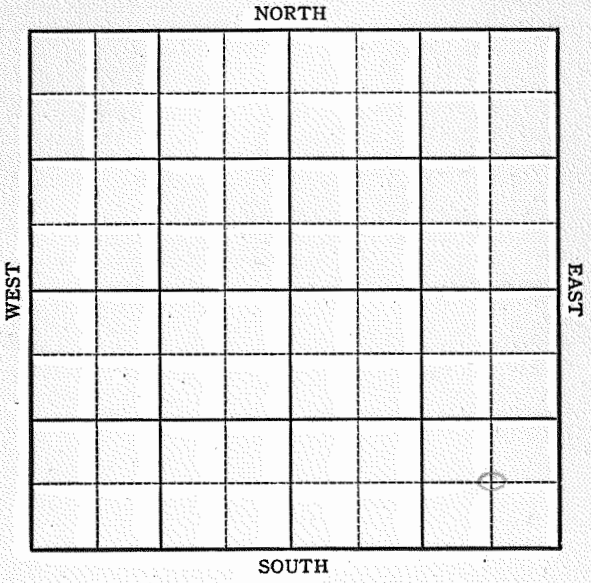

KANSAS Kansas Pool Name Wildcat

Map No. 27 Sec. 27 Twp. 11 R. 2W

Well No. 1 C. A. Quinn

H. B. Peathing Company

FIRST REPORT

Contractor

SE/C

SECTION PLAT

_____ Ft. from N. Line

330 Ft. from S. Line

330 Ft. from E. Line

_____ Ft. from W. Line

Ottawa County

Location _____

Rig up _____

Drilling and Remarks:

200'

RECORD

Cased _____ in., _____ ft.

Sand _____

Gas _____

Oil _____

Total Depth _____

PRODUCTION

1st 24 hrs. Nat. _____

1st 24 hrs. after shot _____

Gas _____ Cu. Ft.

Dry Hole _____

Abandoned _____

Date

AUG 14 1946 19

S. J. LEWIS Scout

Sec. 27 Twp. 11 R. 2W

Well No. #1 C. A. Q uinn Farm _____

H. B. Peatling Company _____

Wildcat


_____ Ft. from N. Line

330 Ft. from S. Line

330 Ft. from E. Line

_____ Ft. from W. Line

SE/c

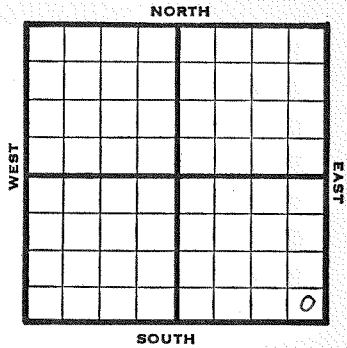

1946

REPORT

Elev. 1310

8/14

200'

8/20

8" @ 170'
Drlg 2200'

8/27

Drlg 3655'

9/5

Miss 2703
Simp 3544
Arb 3623
TD 3655

ABANDONED