

Section 2 Township 11 Range 17 WWell No. # 1 SlimmerCompany Isern Bros.

NORTH

							0

WEST

EAST

SOUTH

8

Ellis

KANSAS

Sec. 2 Twp. 11 R. 17W

Well No. #1 Slimmer Farm

Isern Bros. Company

Wildcat Contractor

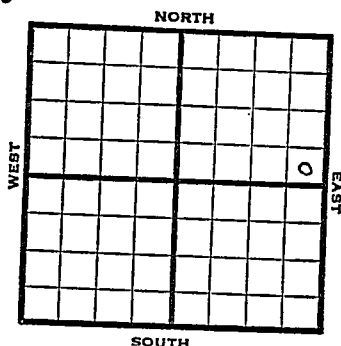
Ft. from N. Line

330 Ft. from S. Line

330 Ft. from E. Line

Ft. from W. Line

SE SE NE



1951

REPORT

10/31

Spud 10-25-51

8" @ 222'

Anhy 1095'

Drlg. 2100'

11/7

Spud 10-25-51

D&A TD 3489

8" @ 222

Anhy 1095'

Heeb. 3060

Lans. 3101

DST 3137-94 open $\frac{1}{2}$ hr.

Rec. 3101

DST 3137-94 open $\frac{1}{2}$ hr.

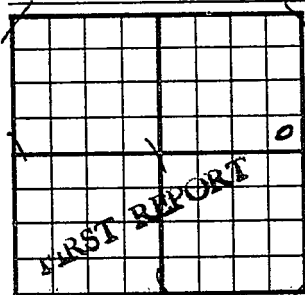
Rec. 330' SW

Cong. 3376

Arb. 3483-89 TD

D&A

ABANDONED

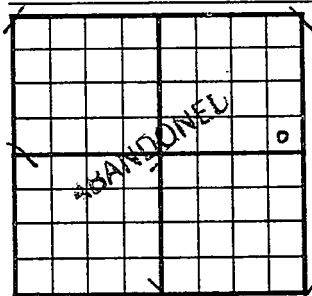
County Ellis State KansasSec. 2 (Blk.) 11 (Sur.) 17W Map No.Operator Isern Bros.Well No. 1 Farm SlimmerElev. Location SE SE NE330 Ft. From S Line NE330 Ft. From E Line QuarterIst. Report OGI 31 1951

Completion

Remarks

Spudding Date 10-25-51Drig. Data Wildcat8" @ 222 Anhy 1095 Drig. 2100

J. E. TYRA

County Ellis State KansasSec. 2 (Blk.) 11 (Sur.) 17W Map No.Operator Isern Bros.Well No. 1 Farm SlimmerElev. 1901 Location SE SE NE330 Ft. From S Line NE330 Ft. From E Line Quarter

1st. Report

Completion NOV 7 1951Remarks WildcatSpudding Date 10-25-51Drlg. Data D & A TD 34898" @ 222 Anhy 1095 Heeb. 3060Lans. 3101 DST 3137-94 open $\frac{1}{2}$ hr/Rec. 330' sw Cong. 3376 Arb. 3483-89 TDD & A

J. E. TYRA