


Section 2 Township 11 Range 16WWell No. #1 Gick "B"Company Cities Service

Bemis

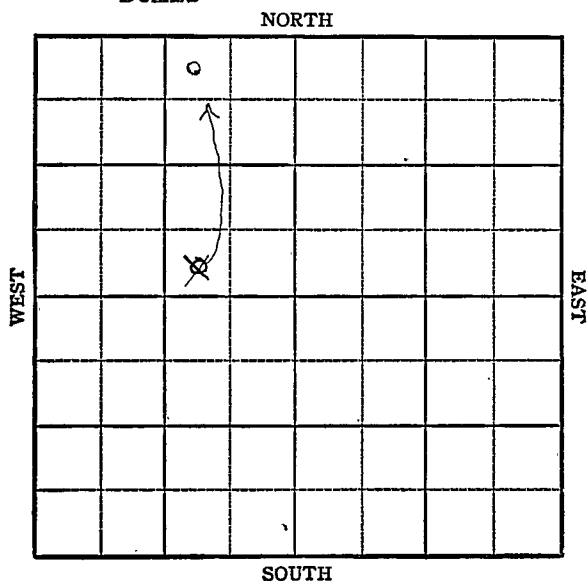

Sec. 2 Twp. 11 R. 16-W ✓

Well No. #1 Gick "B" Farm _____

Cities Service Company

Bemis


330 Ft. from N. Line

_____ Ft. from S. Line

990 Ft. from E. Line

_____ Ft. from W. Line

NW N E NW

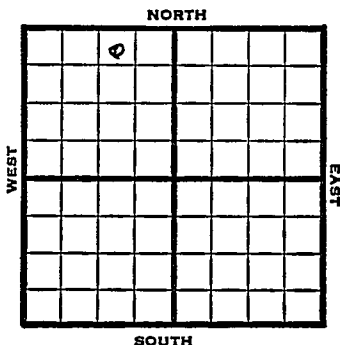

1948

Elev. 2087' REPORT

10/13

8" @ 295'

Drlg 315'

10/19

Drlg 2990'

10/26

Lansing 3256'

TD 3575

5" @ 3563'

11/3

35 shots 3352-62

24 " 3228-38 600' W & 150' oil

11/10

35 shots 3440-50

35 " 3368-98

32 " 3340-48

66 " 3300-18

33 " 3281-90

23 " 3254-60

25 " 3228-36 - 5000 acid

Pump 465 bbls oil 410 W - 21 hrs.

11/16

"

11/23

"

11/30

"

"

12/8

"

"

12/15

"

"

12/22

Lans 3256'

5" @ 3563'

Perf.

5000 Acid

Pump 554 oil Pot.

Gr. 38°

TD 3575'

COMPLETED

Map No. _____ Sec. 2 Twp. 11 R. 16W

Well No. 1 Gick "B"

_____ Cities Service _____ Company

_____ FIRST REPORT _____ Contractor

NW NE NW

SECTION PLAT

330 Ft. from N. Line

_____ Ft. from S. Line

990 Ft. from E. Line

_____ Ft. from W. Line

	0		

Ellis County

Location _____

Rig up _____

Drilling and Remarks:

8" @ 295

drlg. 315

RECORD

Cased _____ in., _____ ft.

Sand _____

Gas _____

Oil _____

Total Depth _____

PRODUCTION

1st 24 hrs. Nat. _____

1st 24 hrs. after shot _____

Gas _____ Cu. Ft.

Dry Hole _____

Abandoned _____

Date

OCT 13 1948 19

S. J. LEWIS Scout

Kansas

Map No. 71 Sec. 2 Twp. 11 R. 16WWell No. 1 Gisk "B"

Cities Service

Company

COMPLETE

Contractor

NW NE NW

E. 12077

SECTION PLAT

330

Ft. from N. Line

Ft. from S. Line

990

Ft. from E. Line

Ft. from W. Line

	0		

Ellis County

Location

Rig up

Drilling and Remarks:

Lans 8256

5-10-3568

Prof.

50000000

Prof 557 oil

350000

RECORD

Cased _____ in., _____ ft.

Sand _____

Gas _____

Oil ☒Total Depth 3525

PRODUCTION

1st 24 hrs. Nat. _____

1st 24 hrs. after shot _____

Gas _____ Cu. Ft.

Dry Hole _____

Abandoned _____

Date

DEC 22 1948

19

S. J. LEWIS

Scout