

KANSAS

Ellis

Section 2 Township 11 Range 16W

Well No. 1 R.C. Bowlby

Company Skelly

Krueger

NORTH

WEST

EAST

		0					

SOUTH

6

Ellis KANSAS

Sec. 2 Twp. 11 R. 16W ✓

Well No. #1 R. C. Bowlby Farm

Skelly Company


Krueger Pool

_____ Ft. from N. Line

990' _____ Ft. from S. Line

990' _____ Ft. from E. Line

_____ Ft. from W. Line

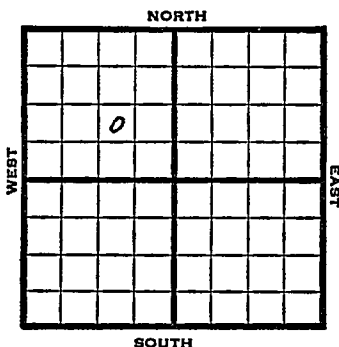

NW SE NW

1949 Elev 2052' REPORT

6/15	Location
6/21	"
6/28	8" @ 302' Drlg 1920'
7/6	Drlg. 3020'
7/12	Lansing 3229' TD 3380 5" @ 3379'
8/20	24 shots 3324-30 200' W 2 hrs.
7/27	Squeeze PB 3328 36 shots 3320-750 acid Pump 185 bbls oil / 80 W 18 hrs.
8/3	"
8/10	Plug 3267 36 shots 3257-61 750 acid Swb 163 bbls oil / 13 W 6 hrs.
8/17	TD 3380' Lansing 3229' 5" @ 3379' Perf 500 acid Pump 743 Oil / 33 W Pot 27° Gr. Comp

COMPLETED

Map No. K71 Sec. 2 Twp. 11 R. 16W

Well No. 1 R. C. Bowlby

Skelly

Company

COMPLETE

Contractor

NW SE NW

E1,2052
SECTION PLAT

_____ Ft. from N. Line

990 Ft. from S. Line

990 Ft. from E. Line

_____ Ft. from W. Line

	o		

Ellis County

RECORD

Location _____

Cased _____ in., _____ ft.

Rig up _____

Sand _____

Drilling and Remarks:

Gas _____

Oil _____

Lease 3229

Total Depth 2380

5" 3379.

Prof.

500000

Pump 74 Boil 738 W

Prod. 27 3/4

PRODUCTION

1st 24 hrs. Nat. _____

1st 24 hrs. after shot _____

Gas _____ Cu. Ft.

Dry Hole _____

Abandoned _____

Date

AUG 17 1949 19

S. J. LEWIS Scout