


Section 2 Township 11 Range 16W

Well No. #5 Bowlby

Company Skelly Oil Co.

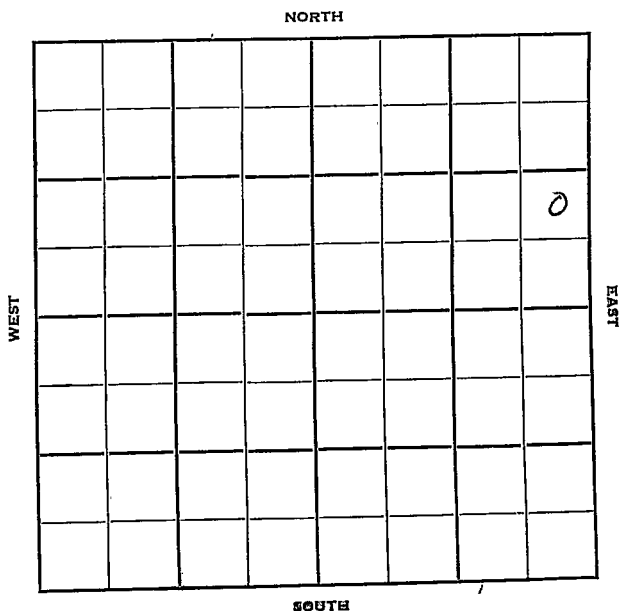

KANSAS

Ellis

Sec. 2 Twp. 11 R. 16-W

Well No. #5 Bowlby Farm

Skelly Oil Co Company

Wentworth, Contr. Contractor
Kruger


 Ft. from N. Line

930 Ft. from S. Line

330 Ft. from E. Line

 Ft. from W. Line

NE SE NE

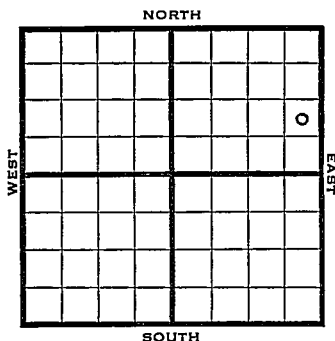


1950 Elev. 2020' REPORT

8/30 Location

10/18 Spud 9-2-50
Oil Well TD 3440'
Anhy 1212' 8" @ 1220'
Top 2949' Toronto 3178'
Lans. 3201' TD 3440'
5" @ 3440' 38/3418-22 500 A
B/1½ BWPB PB 3320'
12/3300-04 10 GWPB 27/3289-98
6 BW 2 hr. SSO
PB 3282' 70/3272-80.
750 A S/48 BO 4 BW 16 hr. 1500 A
S/45 BO 2 BW 15 hr. PB 3267
36/3232-36 6 GWPB
81/3250-59 B/6 BO 6 GWPB
500 A S/25 BO 2 BW 5 hr. 1500 A
S/63 BO 6 BW 6 hr. SP 3243 750 A
3232-36 S/22 BO 2 BW 4 hr. 1500 A
S/181 BO 9 BW 8 hr. PB 3191
54/3176-82 500 A S/24 BO 7 hr
1500 A S/37 BO Comp. 458 BOPD
14% Wtr.

COMPLETED

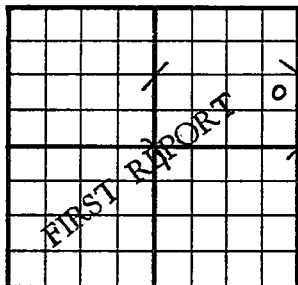County Ellis State KansasSec. 2 (Blk.) 11 (Sur.) 16W Map No.Operator Skelly Oil Co.Well No. 5 Farm BowlbyElev. Location NE SE NE930 Ft. From S Line NE330 Ft. From E Line Quarter1st. Report AUG 30 1950


Completion

Remarks

Spudding Date

Drlg. Data Kruger PoolLocation

J. E. TYRA

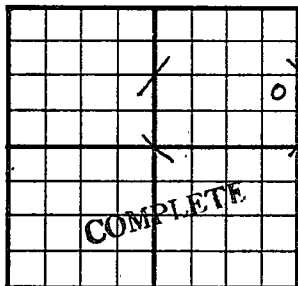County Ellis State KansasSec. 2 (Blk. Twp.) 11 (Sur. Rge.) 16W Map No.Operator Skelly OilWell No. 5 Farm BowlbyElev. 2020 Location NE SE NE

930 Ft. From S Line NE

330 Ft. From E Line Quarter

1st. Report

Completion OCT 18 1950Remarks Kruger PoolWentworth - Contr.Spudding Date 9-2-50Drig. Data Oil well TD 3440Anhy 1212 8" @ 1220 Top. 2949Toronto 3178 Lans. 3201 TD 34405" @ 3440 38/ 3418-22 500 A B/ 1 $\frac{1}{2}$ bwphPB 3320 12/ 3300-04 10 gwph 27/ 3289-98 6 bw 2 hr. SS0 PB 3282 70/ 3272-80750 A S/ 48 bo 4 bw 16 hr. 1500 AS/ 45 bo 2 bw 15 hr. PB 3267 36/ 3232-366 goph 81/ 3250-59 B/ 6 go 6 gwph500 A S/ 25 bo 2 bw 5 hr. 1500 AS/ 63 bo 6 bw 6 hr. SP 3243 750 A3232-36 S/ 22 bo 2 bw 4 hr. 1500 AS/ 181 bo 9 bw 8 hr. PB 3191 54/ 3176-82500 A S/ 24 bo 7 hr. 1500 A S/ 37 boComp. 458 bopd 14% water

J. E. TYRA