


Section 2 Township 11 Range 19W

Well No. 1 O'Brien

Company Okma Oil

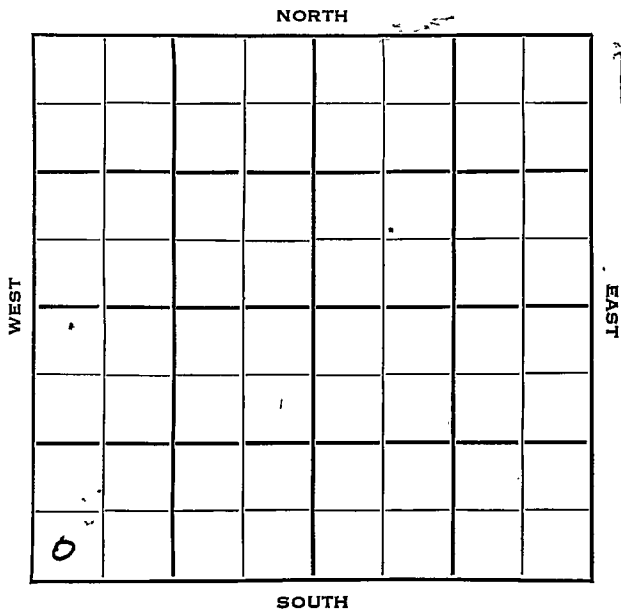

Ellis


KANSAS

SEC.	TWP.	R.
2	11	19W

WELL NO. #1 O'Brien FARM

COMPANY Okmar Oil

CONTRACTOR Trans-Era

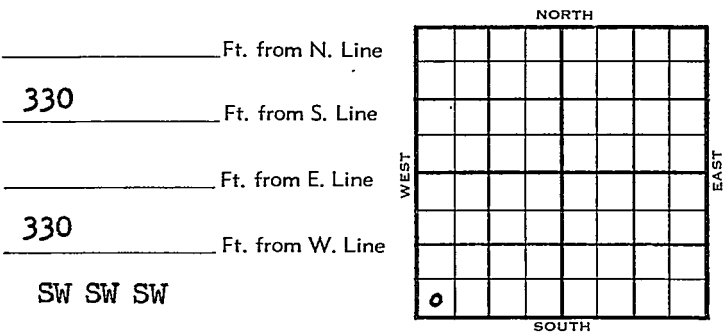

1953	ELEVATION	REPORT
	2105'	

10/28 Spud 10-22-53  
8" @ 207'  
Anhy 1430'  
Drlg 2695'

11/4 Top 3047'  
DST 3069-79, 1 hr, 45' M 850#  
Heeb 3266' Lans 3308'  
DST 3386-98, 1 hr, 500' SW 950#  
DST 3462-86, 1/2 hr, 12' M  
DST 3513-21, 1 hr, 20' OCM 50#  
Cong. 3550'  
Drlg. 3500'

11/11 Spud 10-22-53  
D & A  
TD 3660'  
8" @ 207'  
Anhy 1430', Top 3047'  
DST 3069'-79' opn 1 hr, rec 45' mud  
850# Heeb 3266', Lans 3308'  
DST 3386'-98' opn 1 hr, rec 500' sw,  
950#  
DST 3462'-86' opn 1/2 hr, rec 12' mud,  
0#.  
DST 3513'-21' opn 1 hr, rec 20' ocm  
50# Cong 3550', Simp 3582, Arb 3621'

OVER

1953

Information brought forward.

11/11 DST 3622'-25' opn 1 hr, rec 20' midg  
550#.  
TD 3660'  
D & A

**ABANDONED**



OCT 30 1952

Scout Cards	.....
• Small Maps	.....
and Trail Maps	.....
.....	.....
.....	.....
.....	.....
Misc.	.....

Drig. Data



NOV 16 1952

Scout Cards	.....
Land Street Maps	.....
Land Wall Maps	.....
Tracing	.....
France Map	.....
Pierce Map	.....
Misc.	.....

Dirg Data

