


KANSAS Ellis

FORM 51 IOM 12-46 PETROL

Section 2 Township 11 Range 13W

Well No. 6 Cross

Company Mid States

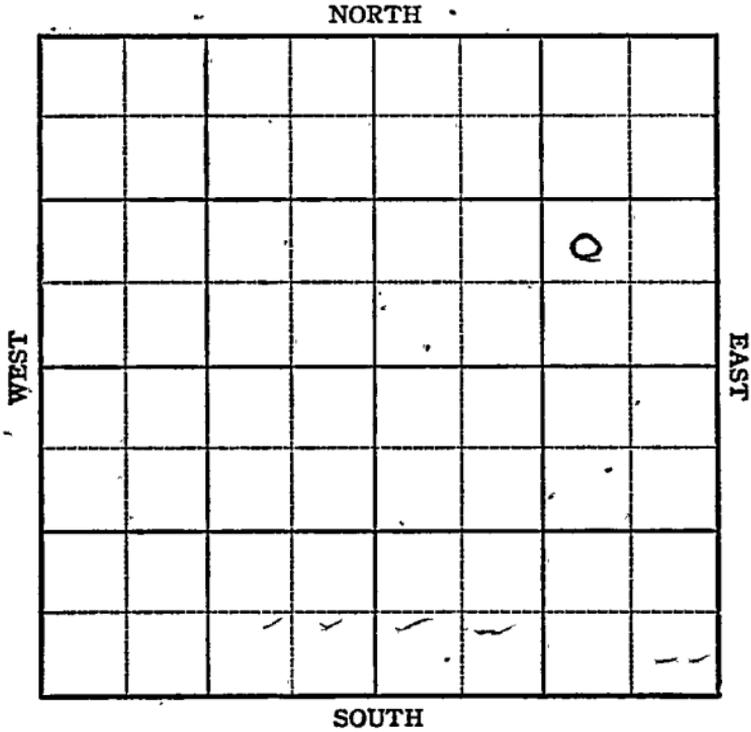

Sec. 2 Twp. 11 R. 18-W

Well No. #6 Cross Farm


Mid-States Company
Burnett

_____ Ft. from N. Line

990 Ft. from S. Line

990 Ft. from E. Line

_____ Ft. from W. Line

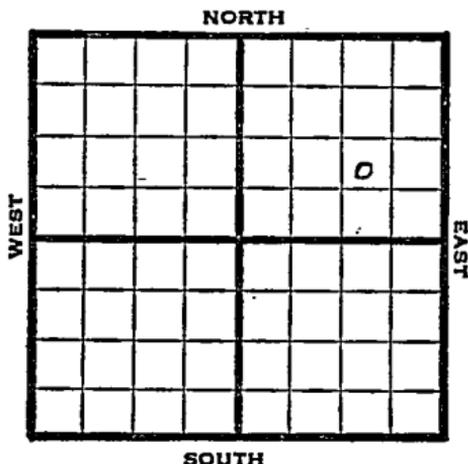

NW SE NE

1947 Elev. 1994' REPORT

- 5/14 Location
- 5/20 RUR
- 5/27 Anhydrite 1294'
10" @ 1303'
Drlg. 2370'
- 6/3 Lansing 3260
Drlg 3410'
- 6/11 Arb. 3707'
TD 3762'

ABANDONED

Kansas Burnett

Map No. K 71 Sec. 2 Twp. 11 R. 18WWell No. 6 Cross

Mid-States Company

FIRST REPORT Contractor

NW SE NE

SECTION PLAT

_____ Ft. from N. Line

990 Ft. from S. Line990 Ft. from E. Line

_____ Ft. from W. Line

			o

Ellis County

Location X

Rig up _____

Drilling and Remarks:

RECORD

Cased _____ in., _____ ft.

Sand _____

Gas _____

Oil _____

Total Depth 990

PRODUCTION

1st 24 hrs. Nat. _____

1st 24 hrs. after shot _____

Gas _____ Cu. Ft.

Dry Hole _____

Abandoned _____

Date

MAY 14 1947

19

S. J. LEWIS

Scout

