

Section 2 Township 11 Range 18WWell No. #10 CrossCompany Mid-States

NORTH

				G			

SOUTH

WEST

EAST

7

Ellis

Sec. 2 Twp. KANSAS R. 18-W ✓

Well No. #10 Cross Farm

Mid-States

Company

Harbar Drlg

Burnett NW

Ft. from N. Line

990


Ft. from S. Line

Ft. from E. Line

330

Ft. from W. Line

NW SW NE

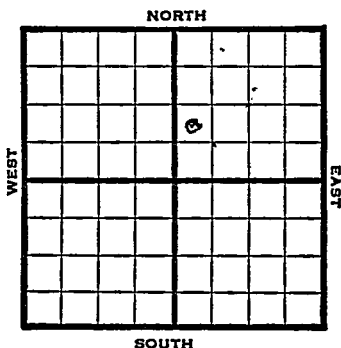

1950

Elev 2050'

REPORT

2/22

Spud 2-17-50

Anhy 1345

8"@ 1355'

WOC

3/15

TD 3652'

8"@ 1355'

5"@ 3556'

Lans 3329'

Cong 3555'

116 BOPD

Comp

COMPLETED

Map No. _____ Sec. 2 Twp. 11 R. 18WWell No. 10 Cross

Mid-States

Company

Harbar Drlg.

Contractor

NW SW NE

El. 2050

SECTION PLAT

		o	
		FIRST REPORT	

_____ Ft. from N. Line

990 Ft. from S. Line

_____ Ft. from E. Line

330 Ft. from W. Line

Ellis County

Location _____

Rig up _____

Drilling and Remarks:

Spud 2-17-50

Anhy 1345

8" @ 1355

WOC

RECORD

Cased _____ in., _____ ft.

Sand _____

Gas _____

Oil _____

Total Depth _____

PRODUCTION

1st 24 hrs. Nat. _____

1st 24 hrs. after shot _____

Gas _____ Cu. Ft.

Dry Hole _____

Abandoned _____

Date

FEB 22 1950 19J. E. TYRA

Scout

Kansas

Map No. _____ Sec. 2 Twp. 11 R. 18WWell No. 10 Cross

Mid-States

Company

Contractor

NW SW NE

E. 2050
SECTION PLAT

COMPLETE			
		o	

Ft. from N. Line

990 Ft. from S. Line

Ft. from E. Line

330 Ft. from W. Line

Ellis County

Location _____

Rig up _____

Drilling and Remarks:

8" @ 13555" @ 3556Lans 3329Cong 3555116 BOPD

RECORD

Cased _____ in., _____ ft.

Sand _____

Gas _____

Oil _____

Total Depth 3652

PRODUCTION

1st 24 hrs. Nat. _____

1st 24 hrs. after shot _____

Gas _____ Cu. Ft.

Dry Hole _____

Abandoned _____

Date

MAR 15 1950 19J. E. TYRA

Scout