


Section 2 Township 11 Range 18W

Well No. #11 Cross

Company Mid-States

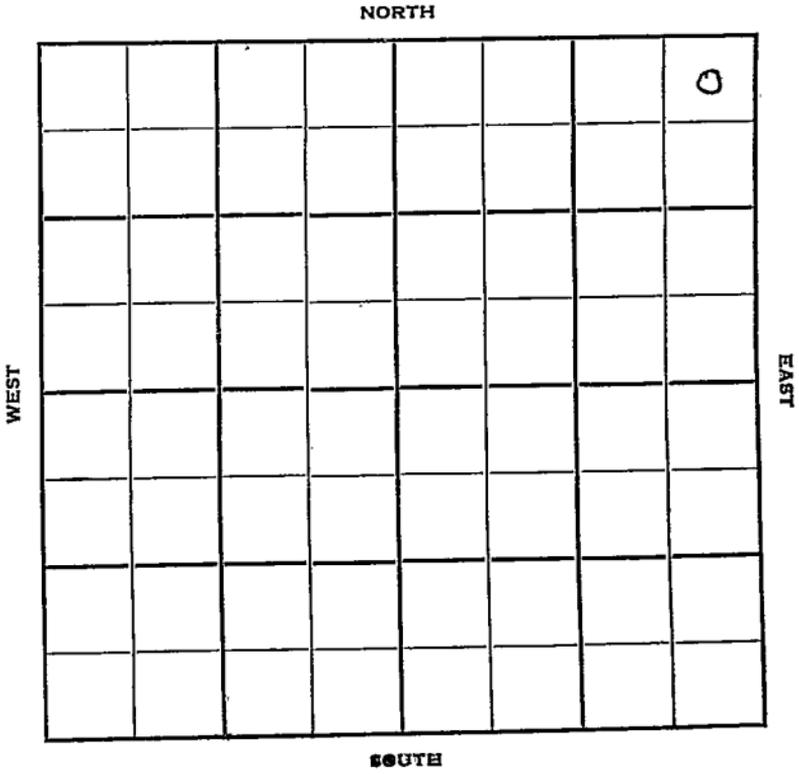

Sec. 2 Twp. 11 R. 18-W

Well No. #11 Cross Farm

Mid-States Company

Harbar Drlg. Contr. Contractor

NW Burnett


330 Ft. from N. Line

\_\_\_\_\_ Ft. from S. Line

330 Ft. from E. Line

\_\_\_\_\_ Ft. from W. Line

NE NE NE

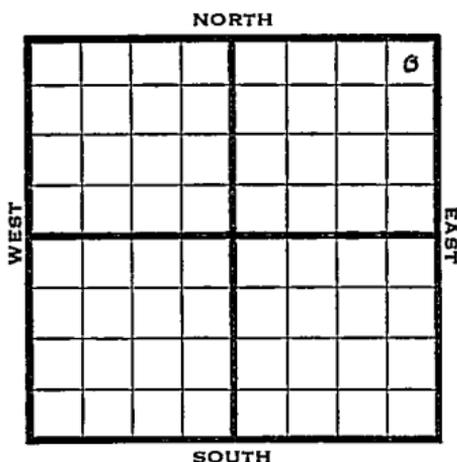

1950 Elev. 2062' REPORT

8/30 Location

9/27 Spud 9-2-50  
 Oil Well TD 3613½  
 8-5/8" @ 1356'  
 Top 3016' Heeb 3246'  
 Lans. 3321'  
 DST 3341-49 opn 30 min.  
 Rec. 65' mud & wtr.  
 BKC 3510' Cong. 3532'  
 Simp Sh 3580' Simp Dol. 3591'  
 Arb. 3609  
 5" @ 3609' TD 3613½  
 FU 2000' oil in 1 hr 250 A  
 Comp. Deptho pot. 2650 BOPD.

**COMPLETED**



County Ellis State Kansas

Sec. 2 (Blk.) 11 (Sur. Rge.) 18W Map No.

Operator Mid-States

Well No. 11 Farm Cross

Elev. 2062 Location NE NE NE

									0

330 Ft. From N Line NE

330 Ft. From E Line Quarter

1st. Report

Completion SEP 27 1950

Remarks NW Burnett Pool

Harbar Drlg. - Contr.

Spudding Date 9-2-50

Drlg. Data Oil well TD 3613 $\frac{1}{2}$

8 5/8" @ 1356 Top. 3016 Heeb. 3246

Lans. 3321 DST 3341-49 open 30 min.

Rec. 65' mud & water B KC 3510

Cong. 3532 Simp. sh. 3580 Simp. dol. 3591

Arb. 3609 5" @ 3609 TD 3613 $\frac{1}{2}$

FU 2000' oil in 1 hr. 250 A

Comp. Deptho. pot. 2650 bopd

J. E. TYRA