

KANSAS


FORM 51 IOM 12-46 PETROL-

Ellis county

Section 2 Township 11 Range 18-W

Well No. #1, Etta Ridler "E"

Company Shell Oil Company

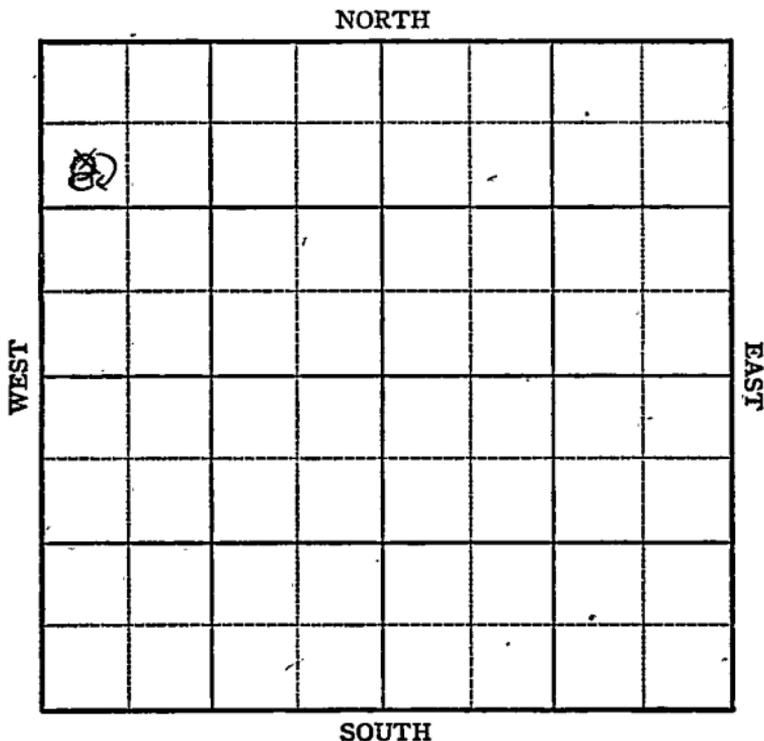

Sec. 2 Twp. 11 R. 18W

Well No. 1 Etta Ridler "E" Farm

Shell Company

Burnett Pool


~~1146~~
~~990~~ Ft. from N. Line

_____ Ft. from S. Line

_____ Ft. from E. Line

330

~~330~~ Ft. from W. Line

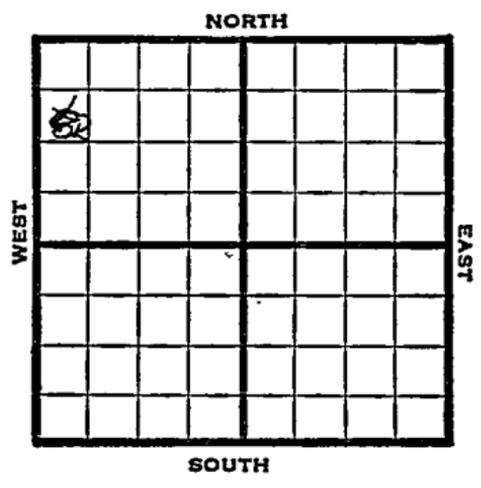

SW NW NW

1947

Elev. 2030

REPORT

1/8

Location

1/15

RUR

1/21

13" @ 138
8" @ 1326
WOC

1/30

Drlg 2807'

2/52

Topeka 3001
Lans 3280
Cong 3492
Drlg 3532'

2/12

~~any~~ 354
Arb. 3570
4" @ 3571'
TD 3575
500 Acid
Shot 97 bbls oil

2/24

4 1/2" casing set 3571 T.D. 3575
Drilled plugs
Filled up 3000' oil in 4 hours
Swabbed 57 Bbls 1st hour
" 69 " 2nd "
" 33 " 3rd "
500 gallons acid
Swabbed 97 bbls net oil 1st hour
State Pot. 3000 Bbls
Bomb Pot. 82,935 bbls.

OVER

2/19 Arb 3570
4" @ 3571
500 Acid
Echo Pot 82,935
Wax 3000
Grav. 30.4
TD 3575'

COMPLETED

Map No. 71 Sec. 2 Twp. 11 R. 18W

Well No. 1 Etta Ridler "E"

Shell Company

FIRST REPORT Contractor

SW NW NW

990 Ft. from N. Line

 Ft. from S. Line

 Ft. from E. Line

330 Ft. from W. Line

Ellis County

SECTION PLAT

Location X

Rig up

Drilling and Remarks:

RECORD

Cased in., ft.

Sand

Gas

Oil

Total Depth

PRODUCTION

1st 24 hrs. Nat.

1st 24 hrs. after shot

Gas Cu. Ft.

Dry Hole

Abandoned


Date

JAN 8 1947 19

S. J. LEWIS

Scout

1031

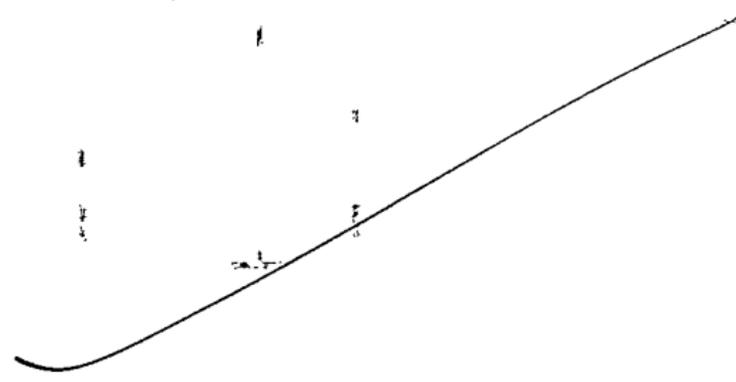

Misc. Small Maps	<i>[Handwritten initials]</i>
Cards	<i>[Handwritten initials]</i>
Tracings	<i>[Handwritten initials]</i>
France Map	<i>[Handwritten initials]</i>
Searborough Map	<i>[Handwritten initials]</i>
Pierce Map	<i>[Handwritten initials]</i>
Geological Dept.	_____
Pierce Flat Book	_____

Kansas

Map No. 71 Sec. 2 Twp. 11 R. 18WWell No. 1 Etta Ridler "E"

Shell


Company

CORRECTION

Contractor

SW NW NW

SECTION PLAT

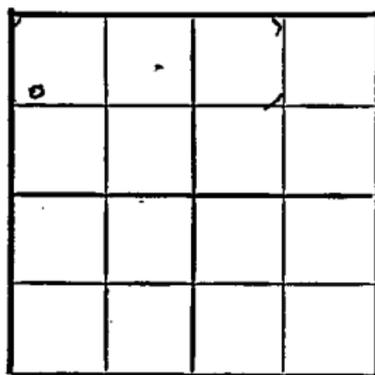1146 Ft. from N. Line Ft. from S. Line Ft. from E. Line330 Ft. from W. Line

Ellis County

Location Rig up

Drilling and Remarks:

Reported
990 x 330

RECORD

Cased in., ft.Sand Gas Oil Total Depth

PRODUCTION

1st 24 hrs. Nat. 1st 24 hrs. after shot Gas Cu. Ft.Dry Hole Abandoned

Date

JAN 15 1947 19

S. J. LEWIS Scout

[Handwritten scribble]

Misc. Small Maps	<i>[Handwritten scribble]</i>
Cards	<i>[Handwritten scribble]</i>
Tracing	<i>[Handwritten scribble]</i>
France Map	<i>[Handwritten scribble]</i>
Scarborough Map	<i>[Handwritten scribble]</i>
Pierce Map	<i>[Handwritten scribble]</i>
Geological Dept.	
Pierce Plat Book	

KANSAS
Kansas

Burnett Pool

Map No. 71 Sec. 2 Twp. 11 R. 18W

Well No. 1 Etta Ridler "E"

Shell Company

COMPLETE Contractor

SW NW NW

E. 1. 2030

SECTION PLAT

1146 Ft. from N. Line

_____ Ft. from S. Line

_____ Ft. from E. Line

330 Ft. from W. Line

0			

Ellis County

Location _____

Rig up _____

Drilling and Remarks:


RECORD

Cased _____ in., _____ ft.

Sand _____

Gas _____

Oil _____

Total Depth 3575

PRODUCTION

1st 24 hrs. Nat. _____

1st 24 hrs. after shot _____

Gas _____ Cu. Ft.

Dry Hole _____

Abandoned _____

Date

FEB 1 9 1947 19

S. J. LEWIS Scout

Misc. Small Maps
Cards *JDS*
Tracing *me*
France Map *me*
Scarborough Map *me*
Pierce Map *me*
Geological Dept.
Pierce Plat Book