

KANSAS

Ellis county

FORM 51 IOM 12-46 PETROL

Section 2 Township 11 Range 18-W

Well No. #1, Watkins

Company Continental Oil Co

0							

NORTH

WEST

EAST

SOUTH

6

Ellis County

Sec. 2 Twp. 11 R. 18W

Well No. 1 Watkins Farm

Continental

Company


Burnett Pool

 Ft. from N. Line

990 Ft. from S. Line

 Ft. from E. Line

330 Ft. from W. Line

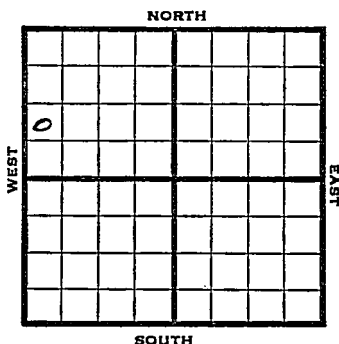

NW SW NW

1947 Elev. 2063' REPORT

1/8 " Drk

1/15 RUR

1/21 Drlg 130'

1/30 10" @ 219
Drlg 2265'

2/5 Lans 3273
Simp 3575
Arb 3598.
TD 3602'
6" @ 3599'
RUST

2/12 Shot 200 bbls oil in 3 hrs

2/19 TD 3616'
Swb 400 bbls oil in 3 3/4 hrs

2/26 " " "

3/4 TD 3616'
Swb 400 bbls oil in 3 3/4 hrs

3/12 Arb 2598'
6" @ 3599'

OVER

3/12 Arb 3598'
6" @ 3599'
Depth Pot 3000
Grav. 27
TD 3616'

COMPLETED

Map No. 71 Sec. 2 Twp. 11 R. 18W

Well No. 1 Watkins

Continental Company

FIRST REPORT Contractor

NW SW NW

 Ft. from N. Line

990 Ft. from S. Line

 Ft. from E. Line

330 Ft. from W. Line

SECTION PLAT

o			

Ellis County

Location

Rig up

Drilling and Remarks:

Derrick

RECORD

Cased in., ft.

Sand

Gas

Oil

Total Depth

PRODUCTION

1st 24 hrs. Nat.

1st 24 hrs. after shot

Gas Cu. Ft.

Dry Hole

Abandoned

Date

JAN 8 1947 19 S. J. LEWIS Scout

Misc. Small Maps ✓
Cards ✓
Tracing ✓
France Map ✓
Searborough Map ✓
Pierce Map ✓
Geological Dist. ✓
Pierce ✓

KANSAS

Kansas

Burnett Pool


Map No. 71 Sec. 2 Twp. 11 R. 18WWell No. 1 WatkinsContinental

Company

COMPLETE

Contractor

NW SW NW

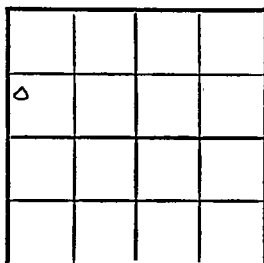F12063
SECTION PLAT Ft. from N. Line990 Ft. from S. Line Ft. from E. Line330 Ft. from W. Line

Ellis County

Location Rig up

Drilling and Remarks:


RECORD

Cased in., ft.Sand Gas Oil Total Depth 8283000

PRODUCTION

1st 24 hrs. Nat. 1st 24 hrs. after shot Gas Cu. Ft.Dry Hole Abandoned

Date

MAR 12 1947 19

S. J. LEWIS Scout

Misc. Small Maps
Cards *De*
Tracing *ME*
France Map *←*
Scarborough Map *De*
Pierce Map *ME*
Geological
Pierce P