KANSAS


Ellis

FORM 51 IOM 12-46 PETROL

Section 2 Township 11 Range 18W

Well No. 2 Watkins

Company Continental

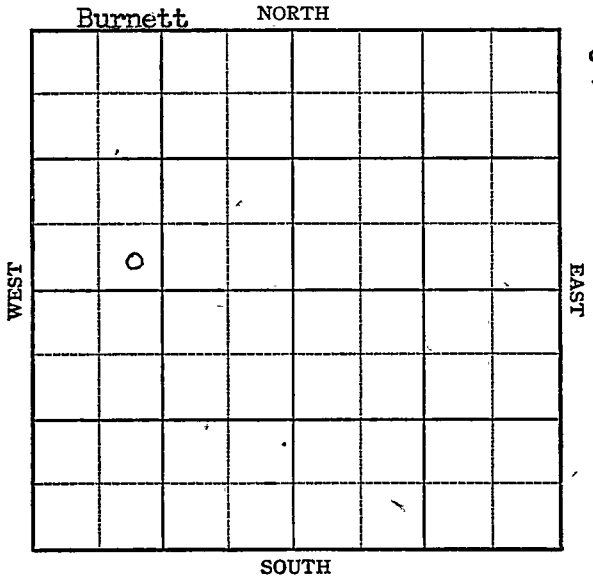

FORM 252-A
5M 12-46 PETROL

Ellis KANSAS

Sec. 2 Twp. 11 R. 18W

Well No. #2 Watkins Farm

Continental Company

Burnett


____ Ft. from N. Line

330 Ft. from S. Line

____ Ft. from E. Line

990 Ft. from W. Line

SE SW NW

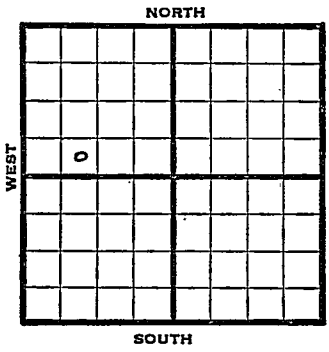

1947	2049 REPORT
4/2	RUR
4/9	10" @ 245' Drlg 1958'
4/15	Drlg. 3164'
4/23	Lans 3233 Arb 3571 5" @ 3572' TD 3575' 3300' oil in 1/3 hr
4/30	Arb 3571' 5" @ 3572' Echo Pot 3000 Grav. 27.5 TD 3575'
	COMPLETED

Form 26 200 Bks. 10-46 Petrol

Burnett Pool

Kansas

Map No K71 Sec. 2 Twp. 11 R. 18W


Well No. 2 Watkins

Continental Company

FIRST REPORT Contractor

SE SW NW

SECTION PLAT

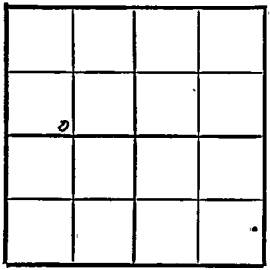

____ Ft. from N. Line

330 Ft. from S. Line

____ Ft. from E. Line

990 Ft. from W. Line

Ellis County

Location

Rig up

Drilling and Remarks:

R U R

RECORD

Cased ____ in., ____ ft.

Sand

Gas

Oil

Total Depth

PRODUCTION

1st 24 hrs. Nat.

1st 24 hrs. after shot

Gas ____ Cu. Ft.


Dry Hole

Abandoned

Date

APR 2 1947 19

S. J. LEWIS Scout

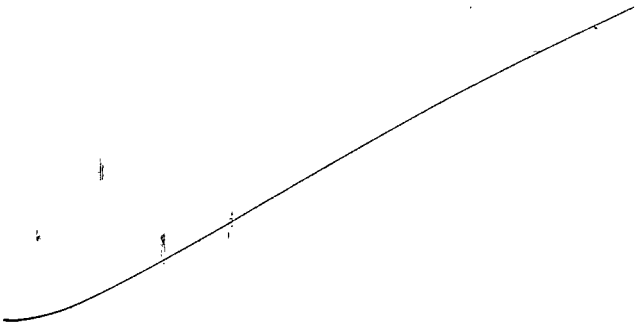

Misc. Small Maps
Cards
Tracing
France Map
Scarborough Map
Pierce Map
Geological Dept.
Pierce Plat Book

Form 26 200 Bks. 10-46 Petrol KANSAS Burnett Pool
Kansas

Map No. K-71 Sec. 2 Twp. 11 R. 18W


Well No. 2 Watkins

Continental Company

COMPLETE Contractor

SE SW NW

El. 2049
SECTION PLAT

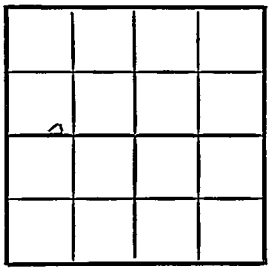

____ Ft. from N. Line

330 Ft. from S. Line

____ Ft. from E. Line

990 Ft. from W. Line

Ellis County

Location

Rig up

Drilling and Remarks:

CP #3571
5-CP-3572
Ech & RS-YB 600

27 5 Gl

RECORD

Cased ____ in., ____ ft.

Sand

Gas

Oil

Total Depth 3575

PRODUCTION

1st 24 hrs. Nat.

1st 24 hrs. after shot


Gas ____ Cu. Ft.

Dry Hole

Abandoned

Date

APR. 30 1947 19 S. J. LEWIS Scout

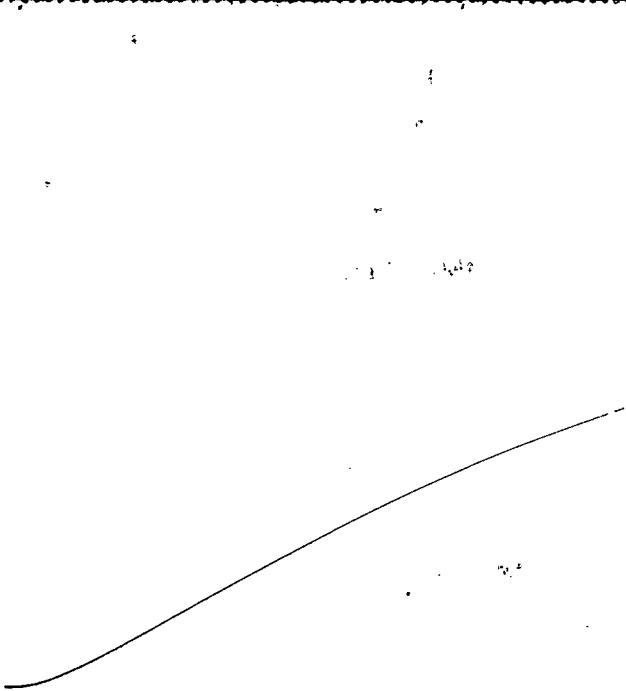

Misc. Small Maps
Cards
Tracings
Frames Map
Scarborough Map
Pierce Map
Geological Dept.
Pierce Plat Book